

WATER SERVICE RECORD

Name

Service No.

Address

Location 24 Woodcliffe Road


Repair—Renewal—New Service

Date		Material	Amount	Total	Date	Amount
5-9-	49					
		70' 3/4" Copper				
		1 3/4" C. X 1/2" I.W.H. Stop & Waste			5-9-49	
		1 3/4" C. X 3/4" C. 3 Part Union				38' 3/4" Copper
7-21-	64	Repair				1 3/4" C. Corp Cock
		12' 3/4" Copper				1 3/4" C. X 3/4" C. Curb Cock
		1 3/4" C. Corp Cock				1 Box & Rod
		1 3/4" C. 3 Part Union				1 1/2" Offset Tail Piece
1-27-	98	New service from old curb To New house				

TOWN OF LEXINGTON — BOARD OF PUBLIC WORKS

WATER DIVISION

Sketch of Service Here **24**

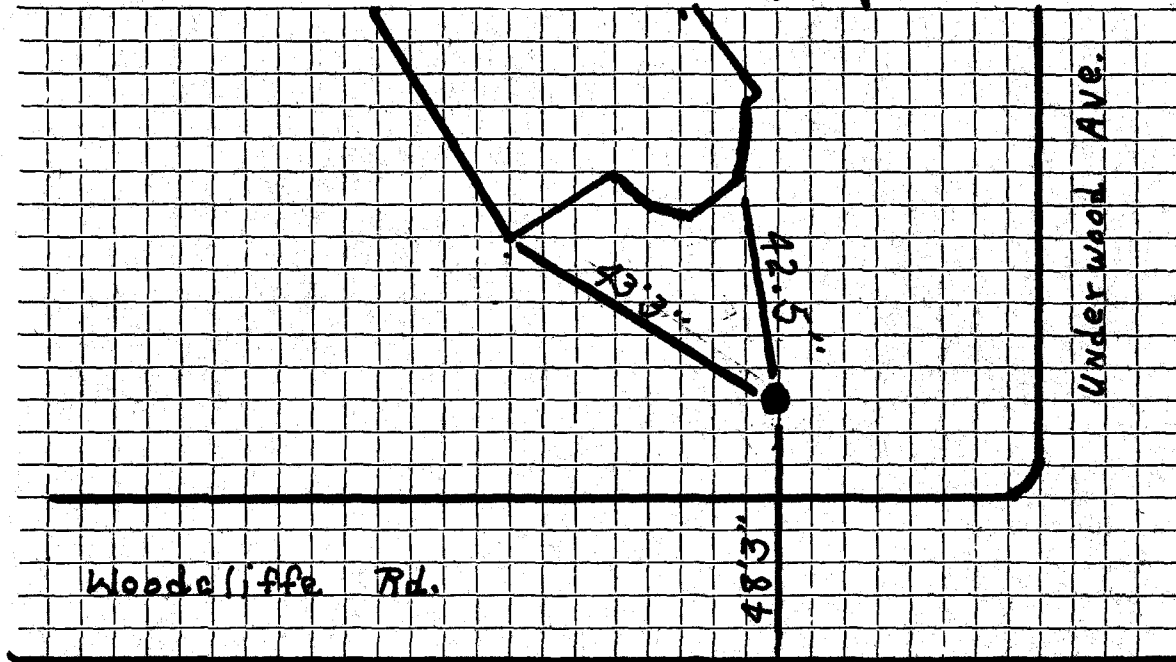

Connection made in ..... Street. Work completed  $\frac{229}{9}$  .....

Remarks: Original House Torn Down - New house Built - service extended .....  
1-27-98 New Service from Curb To New house .....