

Name Custom Built Homes

Service No. 41

Address 25 Woodcliffe Road

Lexington, Mass.

Location 25 Woodcliffe Road

Kind of Pipe

Size

Size of Main

Repair - Renewal - New Service

Com. 6-11-49

Location

Date	Material	Amount	Total	Date	Amount
May 9, '49	Labor	4 00	4 00	May 30 '49	30 00
	10% Overhead		40		
	64' - 3/4" Copper Tubing @.27		17 28		Non-Charge
	1 - 3/4" C x 1/2" I.W.H. S&W		3 29	May 9, '49	Labor 4 05
	2 - 3/4" C x 3/4" C Union (5Bts)		2 78	14' - 3/4" Copper Tubing @.27	3 78
	Trucking 1 hr. @.75		75	1 - 3/4" C Corp-cock	3 15
	INSTALLED BY PLUMBER		28 50	1 - 3/4" C x 3/4" C Curb-cock	3 85
7/22/86	2' 3/4" Copper			1 - Box & Rod	3 95
	2 3/4" Comp. Unions			1 - 1/2" Straight Tail Piece	37
				1 - 1/2" Offset Tail Piece	37
				Littlefield Shovel 1 hr. @7.00	7 00
				Trucking 1 hr. @.75	75
	Labor				27 27

TOWN OF LEXINGTON - BOARD OF PUBLIC WORKS

WATER DIVISION

The undersigned applies for a supply of water at No..... St. and hereby agrees to comply with the rules and regulations as now, or at any future time, established by the Board of Selectmen.

Am't of Estimate \$.....

Owner


Am't Paid \$.....

Address

Builder

.....

Sketch of Service Here

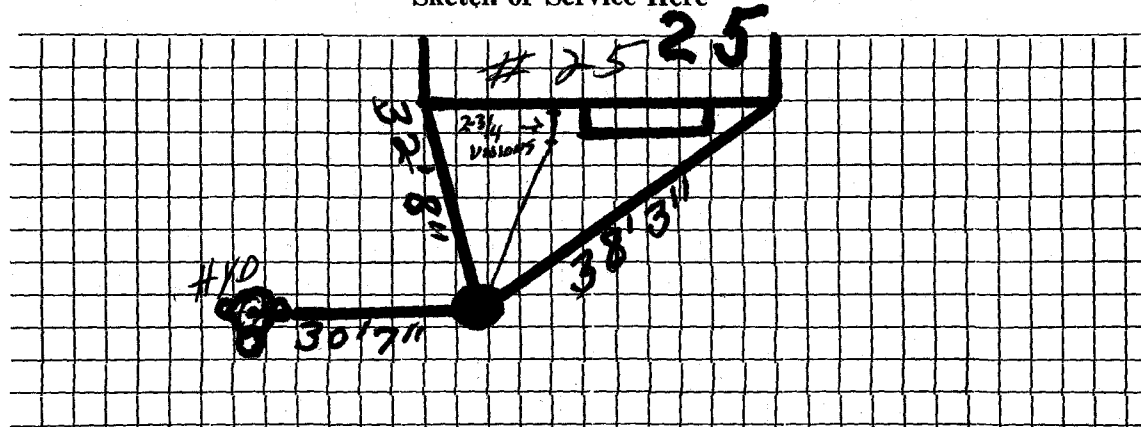

Connection made in Street.

Work completed19

Remarks: