

Name Custom Built Homes

Service No. 41

Address 27 Woodcliffe Road

904

Lexington, Mass.

Location 27 Woodcliffe Road

Kind of Pipe

Size

Size of Main

~~Repair~~ - New Service

Com. 6-11-49

Location

Date	Material	Amount	Total	Date	Amount
May 9, '49	Labor	4 00	4 00	May 30 '49	30 00
	10% Overhead		40		
	72' - 3/4" Copper Tubing @.27		19 44		Non-Charge
	1 - 3/4" C x 1/2" I.W.H. S&W		3 29	May 9, '49	Labor 4 05
	2 - 3/4" C x 3/4" C Union		2 78		10' - 3/4" Copper Tubing @.27 2 70
	Trucking 1 hr. @.75		75		1 - 3/4" C Corp-cock 3 15
			30 66		1 - 3/4" C x 3/4" C Curb-cock 3 85
					1 - Box & Rod 3 95
					1 - 1/2" Straight Tail Piece 37
					1 - 1/2" Offset Tail Piece 37
					Littlefield Shovel 1 hr. @7.00 7 00
					Trucking 1 hr. @.75 75
	Labor				26 19

DATE _____

TOWN OF LEXINGTON - BOARD OF PUBLIC WORKS

WATER DIVISION

The undersigned applies for a supply of water at No..... St. and hereby agrees to comply with the rules and regulations as now, or at any future time, established by the Board of Selectmen.

Am't of Estimate \$.....

Owner


Am't Paid \$.....

Address

Builder

.....

Sketch of Service Here

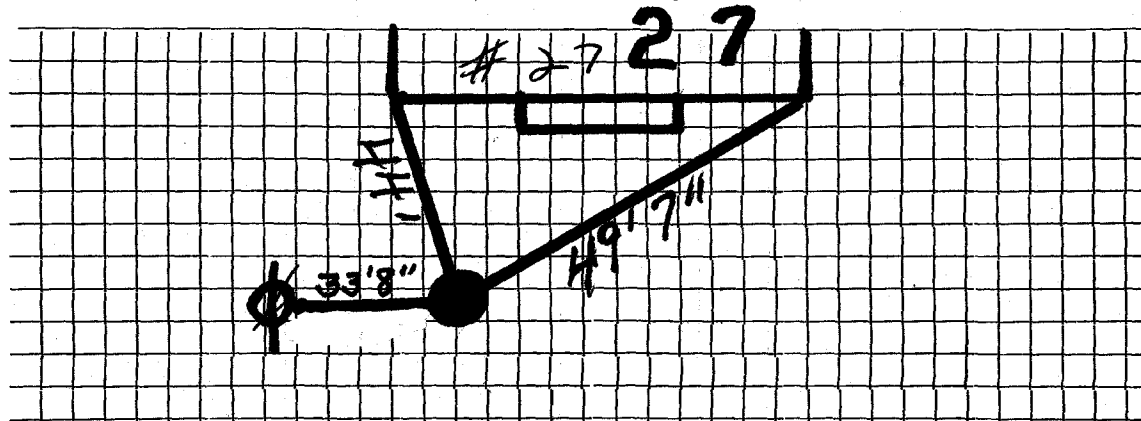

Connection made in Street.

Work completed19

Remarks: