

Name Carson Homes, Incorporated

Service No. 106

Address 29 Woodcliffe Road

Lexington, Mass.

Location 29 Woodcliffe Road

Kind of Pipe

Size

Size of Main

~~Repair-Removal~~—New Service

Com. 9-5-50

Location

Date	Material	Amount	Total	Date	Amount
May 22, '50	Labor	1 50	1 50	May 22 '50	10 00
	10% Overhead		15		
	1 - 3/4" C x 1/2" I.W.H. S&W		3 29		5 69
	Trucking 1 hr. @.75		75		
			5 69		
				May 22, '50	19 48
				50' - 3/4" Copper Tubing @.23	11 50
				1 - 3/4" C Corp-cock	3 15
				1 - 3/4" C x 3/4" C Curb-cock	3 85
				1 - Box & Rod	3 60
				1 - 1/2" Offset Tail Piece	38
				1 - 1/2" Straight Tail Piece	38
				Town Shovel 2 hrs. @ 3.00	6 00
				Allis Chalmers 2 hrs. @ 3.00	6 00
	Labor			Trucking 1 hr. @.75	75
					55 09

DATE _____

TOWN OF LEXINGTON - BOARD OF PUBLIC WORKS

WATER DIVISION

The undersigned applies for a supply of water at No..... St. and hereby agrees to comply with the rules and regulations as now, or at any future time, established by the Board of Selectmen.

Am't of Estimate \$.....

Owner


Am't Paid \$.....

Address

Builder

.....

Sketch of Service Here

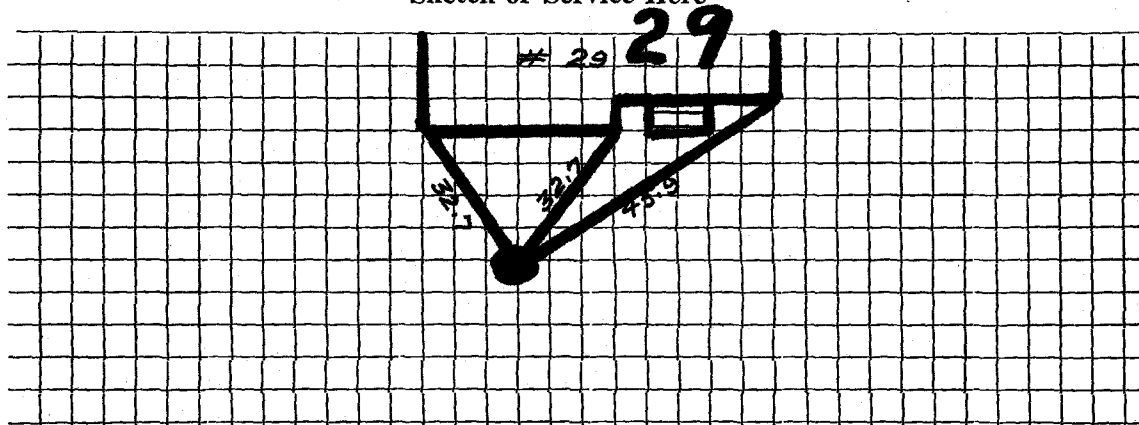

Connection made in Street.

Work completed19

Remarks: