

WATER SERVICE RECORD

Name

Service No.

Address 31 WOODCLIFFE RD

Location

Repair ~~Renewal~~ New Service McLAUGHLIN


Date	Material	Amount	Total	Date	Material	Amount
12/29/98	59' - 1" COPPER			May 9 1949	EXISTING	
	3/4 TO 1" COMP ADPT.				16' 3/4 COPPER	
					1 3/4 CURB COCK	
					1 3/4 CORP	
					Box + Rod	

DATE _____

TOWN OF LEXINGTON — BOARD OF PUBLIC WORKS

WATER DIVISION

Sketch of Service Here

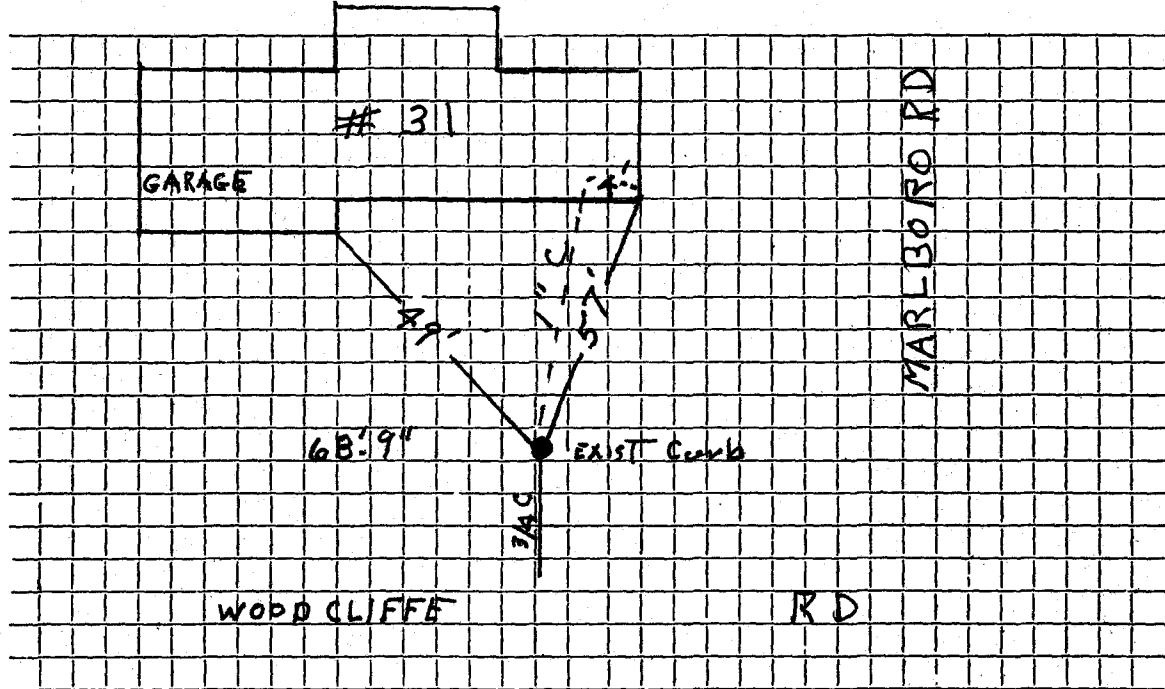

Connection made in Street. Work completed

Remarks:

.....

.....