


DATE May 16, 2020

TOWN OF LEXINGTON — BOARD OF PUBLIC WORKS

WATER DIVISION

Sketch of Service Here

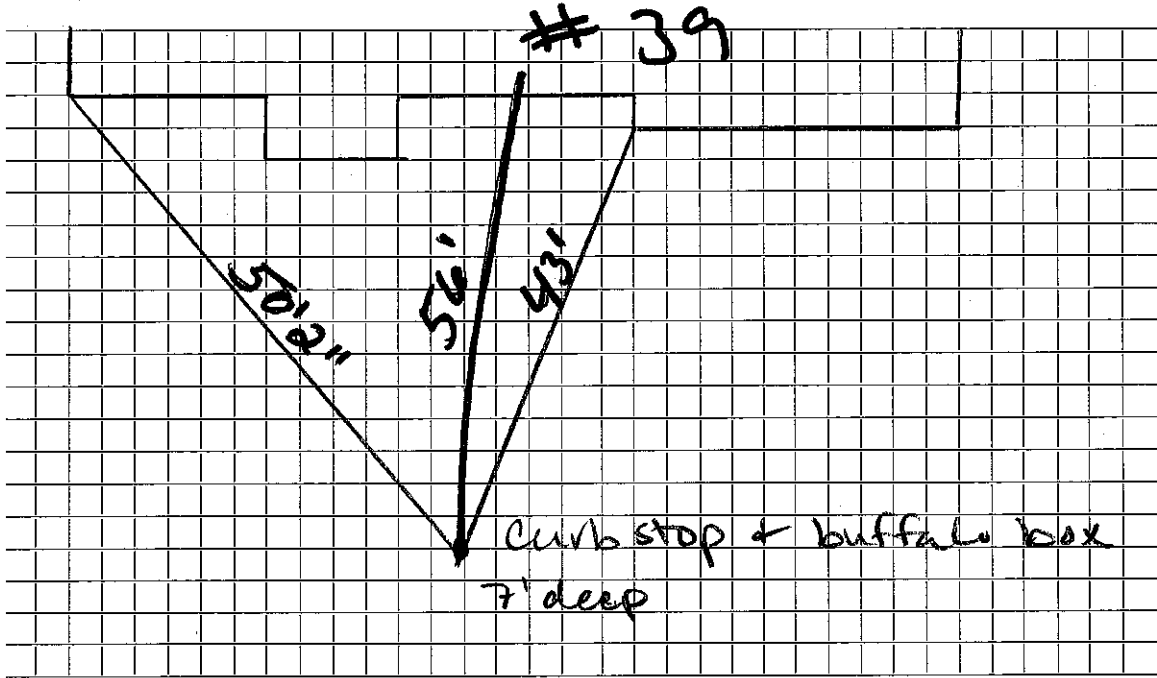

Connection made in Woodcliffe Ave Street. Work completed

Remarks: