

WATER SERVICE RECORD

Name

Service No.

Address 41 Woodcliffe Rd

Location Permit # 1370

Repair—Renewal—New Service


Date	Material	Amount	Total	Date	Amount
4/10/00	Inside			MAY-1949	Outside
70'	1" COPPER			1	3/4" CURB
				1	1" INCREASE
				19'	3/4" C
				1	3/4" COP

DATE 4/10/00

TOWN OF LEXINGTON — BOARD OF PUBLIC WORKS

**WATER DIVISION**

Sketch of Service Here

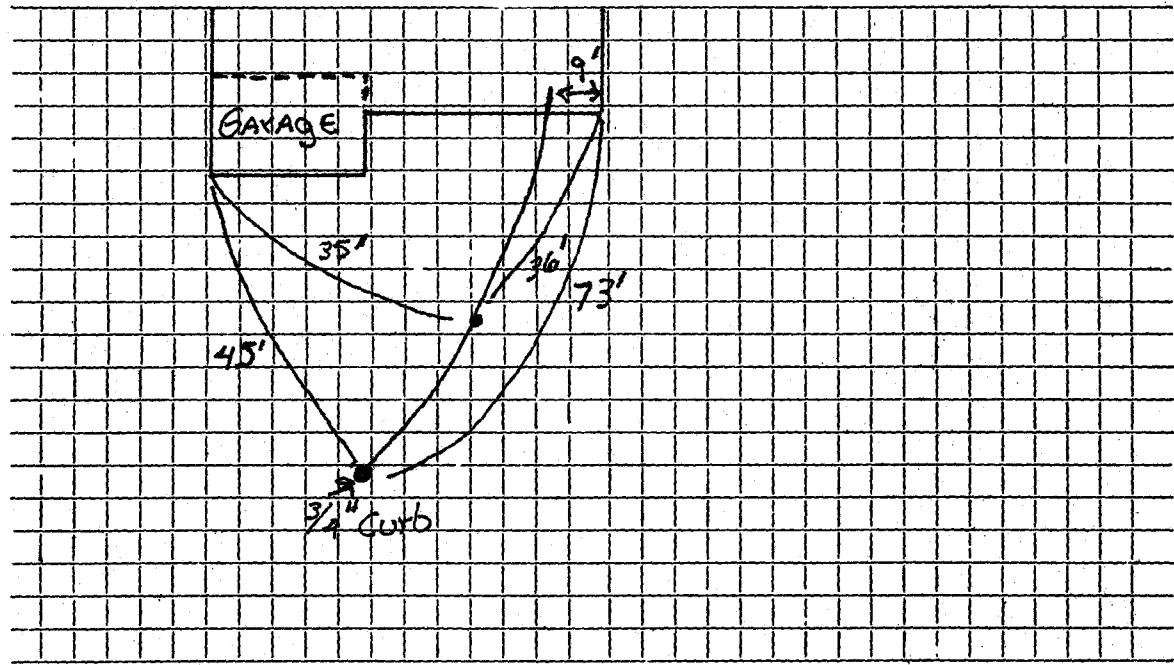

Connection made in ..... Street. Work completed .....

Remarks: .....  
.....  
.....