

Name Custom Built Homes

Service No. 411

Address 42 Woodcliffe Road # 994

Lexington, Mass.

Location 42 Woodcliffe Road

Kind of Pipe

Size

Size of Main

~~XXXXXXXXXX~~ New Service

Com. 6-14-49

Location

Date	Material	Amount	Total	Date	Amount
May 9, '49	Labor	4 00	4 00	May 30, '49	30 00
	10% Overhead		40		
	76' - 3/4" Copper Tubing @.27		20 52		Non-Charge
	1 - 3/4" C x 1/2" I.W.H. S&W		3 29	May 9, '49	4 05
	1 - 3/4" C x 3/4" C Union (3pts)		1 39	20' - 3/4" Copper Tubing @.27	5 40
	Trucking 1 hr. @.75		75	1 - 3/4" C Corp-cock	3 15
			30 35	1 - 3/4" C x 3/4" C Curb-cock	3 85
				1 - Box & Rod	3 95
				1 - 1/2" Straight Tail Piece	37
				1 - 1/2" Offset Tail Piece	37
				Littlefield Shovel 1 hr. @7.00	7 00
				Trucking 1 hr. @.75	75
	Labor				28 89

TOWN OF LEXINGTON - BOARD OF PUBLIC WORKS

**WATER DIVISION**

The undersigned applies for a supply of water at No..... St. and hereby agrees to comply with the rules and regulations as now, or at any future time, established by the Board of Selectmen.

Am't of Estimate \$.....

Owner .....


Am't Paid \$.....

Address .....

Builder .....

.....

Sketch of Service Here

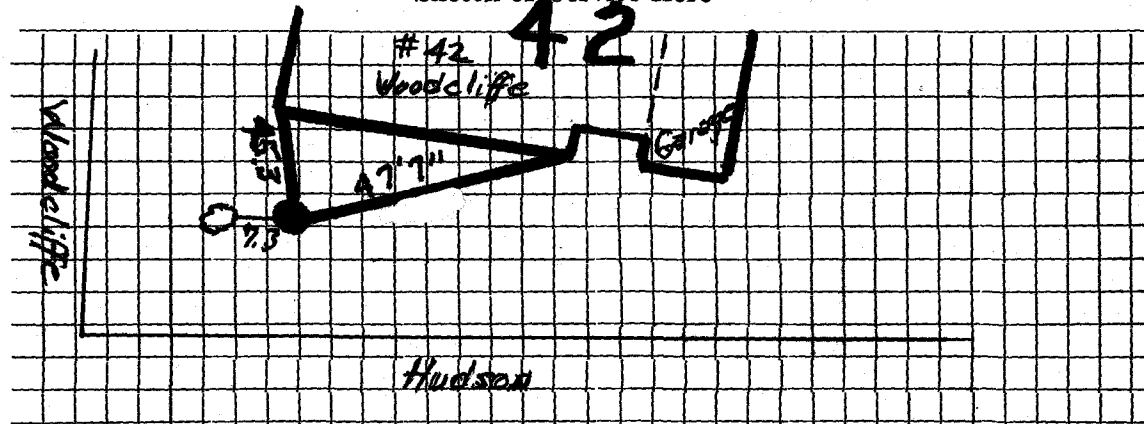

Connection made in ..... Street.

Work completed .....19

Remarks: