

Custom Built Homes

Service No.

111
#4767

Address 43 Woodcliffe Road

Lexington, Mass.

Location 43 Woodcliffe Road

Kind of Pipe

Size

Size of Main

~~XXXXXXXXXX~~ New Service

Com. 6-11-49

Location

Date	Material	Amount	Total	Date		Amount
May 9, '49	Labor	4 00	4 00	Mar 30 '49	Deposited	30 00
	10% Overhead		40			
	73' - 3/4" Copper Tubing @.27		19 71		Non-Charge	
	1 - 3/4" C x 1/2" I.W.H. S&W		3 29	May 9, '49	Labor	4 05
	2 - 3/4" C x 3/4" C Unions(3pts)		2 78	44' - 3/4" Copper Tubing @.27		11 88
	Trucking 1 hr. @.75		75	1 - 3/4" C Corp-cock		3 15
			30 93	1 - 3/4" C x 3/4" C Curb-cock		3 85
				1 - Box & Rod		3 95
				1 - 1/2" Straight Tail Piece		37
				1 - 1/2" Offset Tail Piece		37
				Littlefield Shovel 1 hr. @ 7.00		7 00
				Trucking 1 hr. @.75		75
	Labor					35 37

TOWN OF LEXINGTON - BOARD OF SELECTMEN

WATER DIVISION


The undersigned applies for a supply of water at No..... St. and hereby agrees to comply with the rules and regulations as now, or at any future time, established by the Board of Selectmen.

Am't of Estimate \$..... Owner

Am't Paid \$..... Address

Builder

Sketch of Service Here

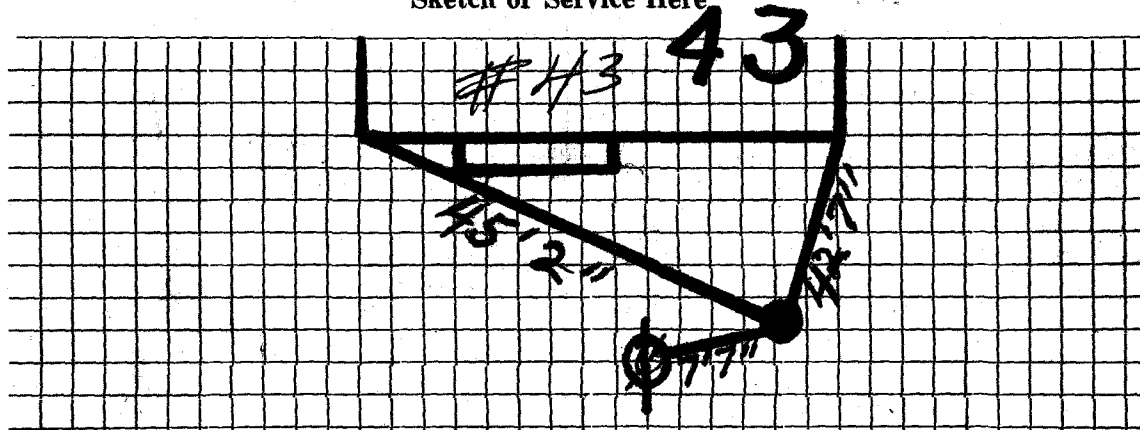

Connection made in Street. Work completed19

Remarks: