

Address 7 Woodcliffe Road

2912

Lexington, Mass.

Location 7 Woodcliffe Road

Kind of Pipe

Size

Size of Main

Report Renewal New Service Com. 6-11-49

Location

Date	Material	Amount	Total	Date	Amount
May 9, '49	Labor	4 00	4 00	Mar 30 '49	Deposited 20 00
	10% Overhead		40		
	63' - 3/4" Copper Tubing @.27		17 01		Non-Charge
	1 - 3/4" C x 1/2" I.W.H. S&W		3 29	May 9, '49	Labor 4 05
	1 - 3/4" C x 3/4" C Union (3pts)		1 39	34' - 3/4" Copper Tubing @.27	9 18
	Trucking 1 hr. @.75		75	1 - 3/4" C Corp-cock	3 15
			26 84	1 - 3/4" C x 3/4" C Curb-cock	3 85
				1 - Box & Rod	3 95
				1 - 1/2" Straight Tail Piece	37
				1 - 1/2" Offart Tail Piece	37
				Littlefield Shovel 1 hr. @ 7.00	7 00
				Trucking 1 hr. @.75	75
					<u>32 67</u>

DATE _____

TOWN OF LEXINGTON - BOARD OF PUBLIC WORKS

WATER DIVISION

The undersigned applies for a supply of water at No..... St. and hereby agrees to comply with the rules and regulations as now, or at any future time, established by the Board of Selectmen.

Am't of Estimate \$.....


Owner

Am't Paid \$.....

Address

Builder

Sketch of Service Here

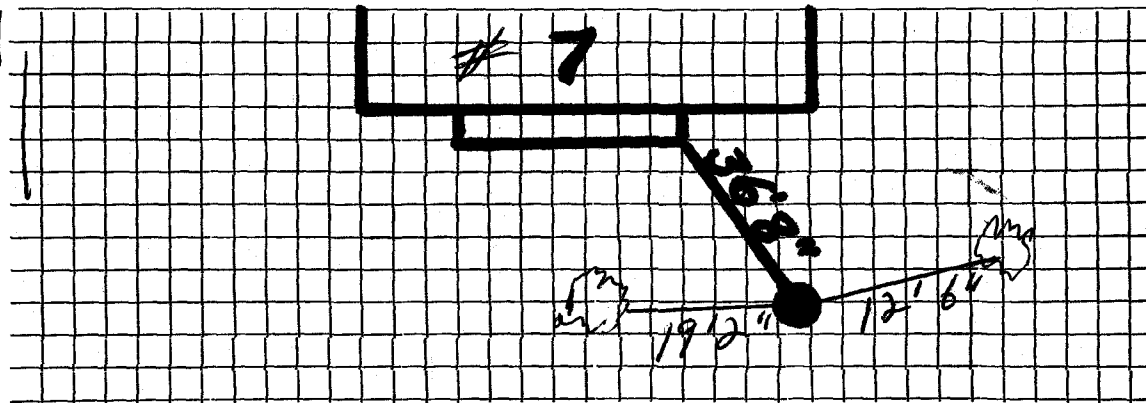

old driveway
old service
gate

Connection made in Street.

Remarks:

Work completed 19

Normandy Rd.