


DATE 27 AUGUST 1996

TOWN OF LEXINGTON — BOARD OF PUBLIC WORKS

WATER DIVISION

Sketch of Service Here

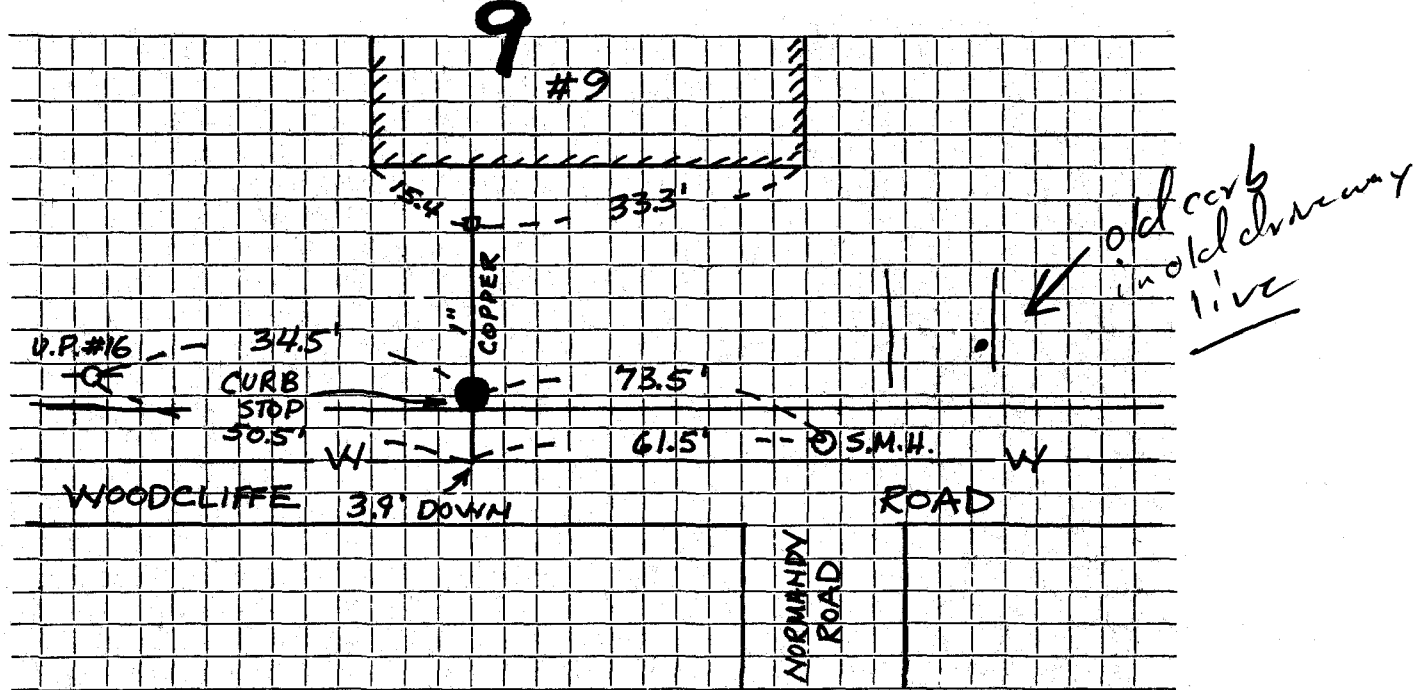

Connection made in WOODCLIFFE ROAD Street.

Work completed BOB GAYLOR

Remarks: