

WATER SERVICE RECORD

curb to main - renewal

Name

Service No.

Address 10 Woodland Road

Location Lexington, Mass.

~~Repair~~ - Renewal - ~~New Service~~


Date	Material	Amount	Total	Date	Amount
5-26-'50'					
	44' 3/4" Copper				
	1 3/4" C. X 1/2" I. W. H. Stop & Waste				
	1 3/4" C. X 3/4" C. 3 Part Union				
				8/1/51 Labor	2 98
				26' - 3/4" copper tubing @ .326	8 48
				1 - 3/4" C. adapter	1 82
				1 - 3/4" C. x 3/4" C. curb-cock	4 67
				1 box and rod	4 68
				1 hr. trucking	75
					<u>23 38</u>

NON CHARGE

DATE _____

TOWN OF LEXINGTON — BOARD OF PUBLIC WORKS
WATER DIVISION

Sketch of Service Here

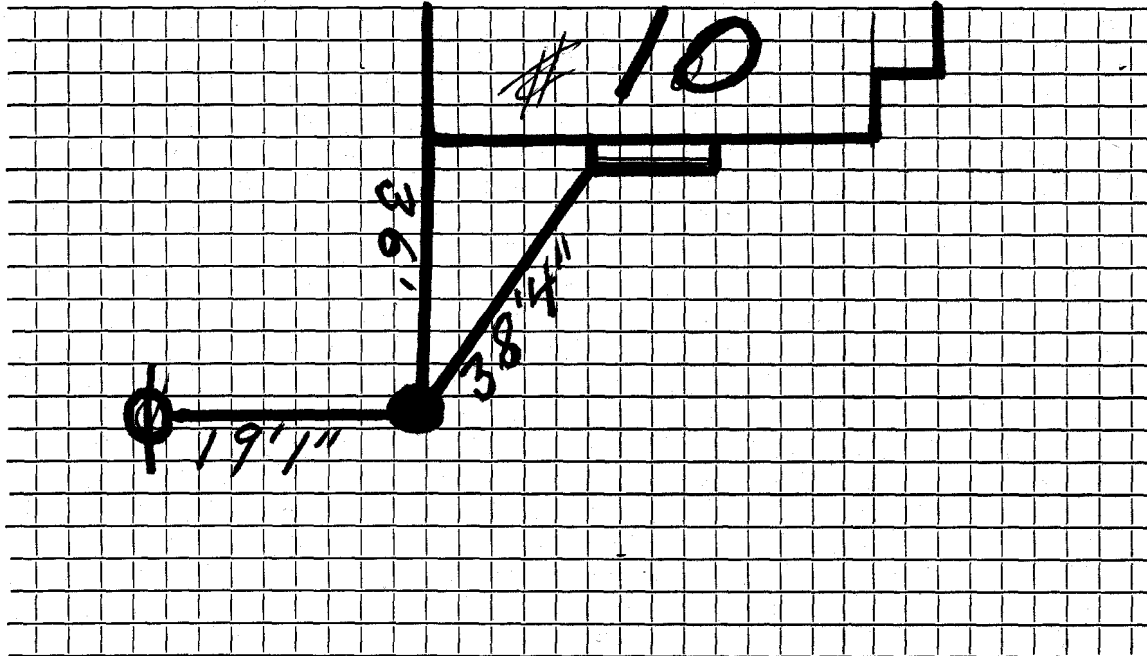

Connection made in Street. Work completed

Remarks:
.....
.....