

Name *G. David Bjorkgren*
 Address *265 Bedford St*

Service No. ⁵⁴ *3053*
35

Location *Lexington*
12 Woodland Rd

Kind of Pipe _____ Size _____ Size of Main _____
 Repair—Renewal—New Service _____ Location _____

Date 1941	Material	Amount	Total	Date	Amount
Sept. 24,	2 hrs. @ 60¢	1 20			
<i>Com 10/13/41</i>	10% Overhead	<u>12</u>	1 32	<i>August 28, 1941</i> Deposited	20 00
	37' 3/4" Copper tubing @ 19¢		7 03	<i>Oct 21, 1941</i> Refund	<u>7 40</u>
	1 3/4" S. & W.		2 50		12 60
	1 3/4" C.Union (3 part)		1 00		
	Trucking, 1 hr.		<u>75</u>		
			12 60		
	Labor				

Hadley Press, Inc., Lexington

DATE Aug 21 1941

TOWN OF LEXINGTON—BOARD OF PUBLIC WORKS

WATER DIVISION

The undersigned applies for a supply of water at No. 12 Woodland St. and hereby agrees to comply with the rules and regulations as now, or at any future time, established by the Board of Selectmen.

Am't. of Estimate \$ 20 -
62 -


Owner A. David Bjorkgren

Am't. Paid \$ _____

Address 265 Bedford St.
Lex.

Builder _____

Sketch of Service Here

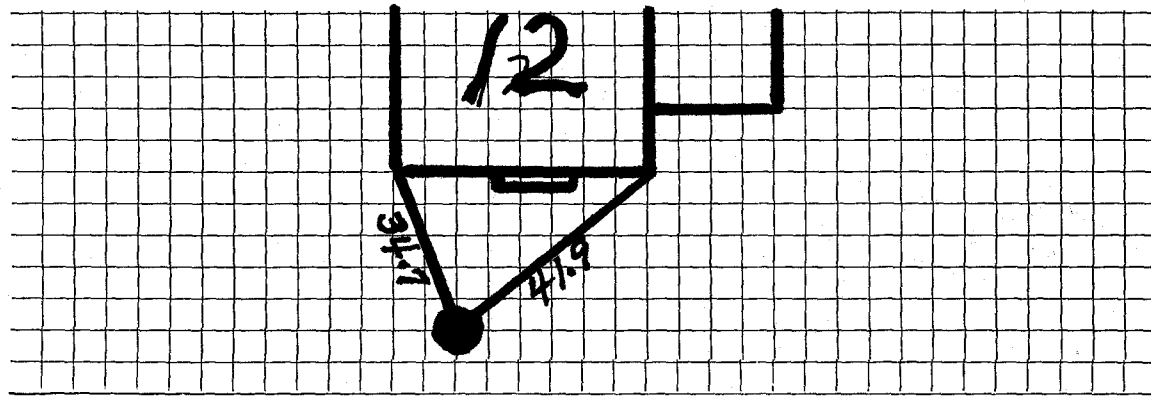

Connection made in _____ Street.

Work completed _____ 19

Remarks: