

Name Richard Soule

Service No. 99 #5040

Address 13 Woodland Road

Lexington, Mass.

Location 13 Woodland Road

Kind of Pipe

Size

Size of Main

~~Repair-Removal~~ New Service

Com. 7-3-50

Location

Date	Material	Amount	Total	Date	Amount	
May 26, '50	Labor	2 00	2 00	May 10 '50	Deposited	50 00
	10% Overhead		20	July 20 '50	Adjusted	9 46
	67' - 3/4" Copper Tubing @.23	15 41			No Charge	40 54
	1 - 3/4"C x 1/2" I.W.H. S&W	3 29		May 26, '50	Labor	2 90
	1 - 3/4"C x 3/4"C Union (3pts)	1 39		20' - 3/4" Copper Tubing @.23		4 60
	Littlefield Shovel 2 1/2 hrs. @7.00	17 50		1 - 3/4" C Corp-cock		3 15
	Trucking 1 hr. @.75	75		1 - 3/4"C x 3/4"C Curb-cock		3 85
			40 54	1 - Box & Rod		3 35
				1 - 1/2" Offset Tail Piece		38
				1 - 1/2" Straight Tail Piece		38
				Littlefield Shovel 1 hr. @ 7.00		7 00
				Trucking 1 hr. @.75		75
	Labor					26 36

TOWN OF LEXINGTON – BOARD OF PUBLIC WORKS

WATER DIVISION

The undersigned applies for a supply of water at No..... St. and hereby agrees to comply with the rules and regulations as now, or at any future time, established by the Board of Selectmen.

Am't of Estimate \$.....

Owner


Am't Paid \$.....

Address

Builder

.....

Sketch of Service Here

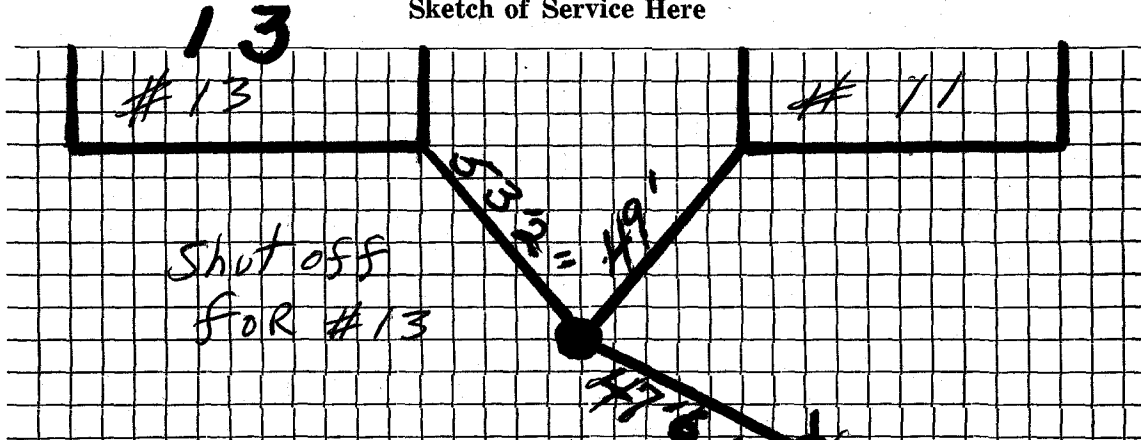

Connection made in Street.

Work completed19

Remarks: