


DATE 9/1/94

TOWN OF LEXINGTON — BOARD OF PUBLIC WORKS

WATER DIVISION

Sketch of Service Here

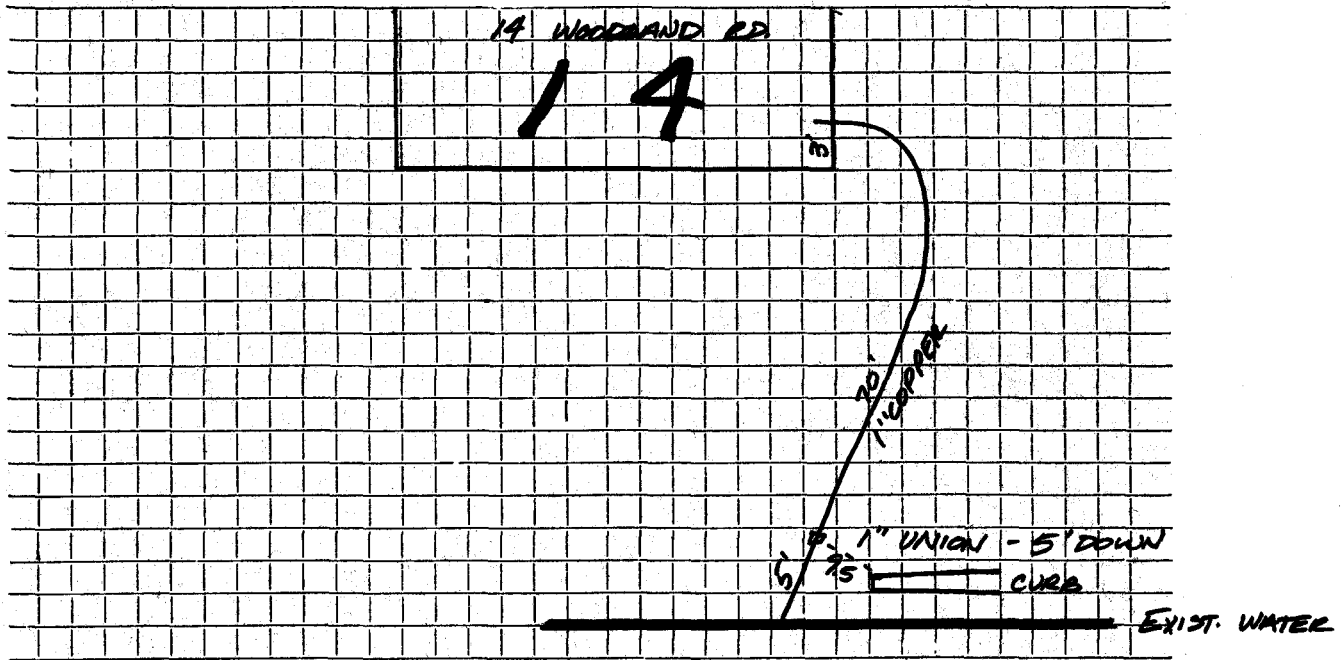

Connection made in WOODLAND Street. Work completed .. ARLEX

Remarks:

.....

.....