

Name Valfred Eriksson

2983

Service No.

289

Address 19 Woodland Road

6911

Lexington, Mass.

Location 19 Woodland Road

Kind of Pipe

Size

Size of Main

~~Repair~~ ~~XXXXXX~~ New Service

Location

Date	Material	Amount	Total	Date	Amount
Dec. 22, '48	Labor	20 48	20 48	Dec. 14, '48	40 00
	10% Overhead		2 05	Dec. 31, '48	1 33
	48' - 3/4" Copper Tubing @ .255	12 24			38 67
	1 - 3/4" C x 1/2" I.W.H. S&W	3 15			
	Trucking 1 hr. @ .75		75	Dec. 22, '48	28 89
			38 67	12' - 3/4" Copper Tubing @ .255	3 06
				1 - 3/4" C Corp-cock	3 00
				1 - 3/4" C x 3/4" Curb-cock	3 68
8-24-73				1 - Box & Rod	3 55
	4' 3/4 Copper	2.50		1 - 1/2" Offset Tail Piece	30
	1 3/4 89 Union	5.10		1 - 1/2" Straight Tail Piece	30
				Trucking 1 hr. @ .75	75
					43 53
	Labor				

DATE _____

TOWN OF LEXINGTON - BOARD OF PUBLIC WORKS

WATER DIVISION

The undersigned applies for a supply of water at No..... St. and hereby agrees to comply with the rules and regulations as now, or at any future time, established by the Board of Selectmen.

Am't of Estimate \$.....


Owner

Am't Paid \$.....

Address

Builder

Sketch of Service Here

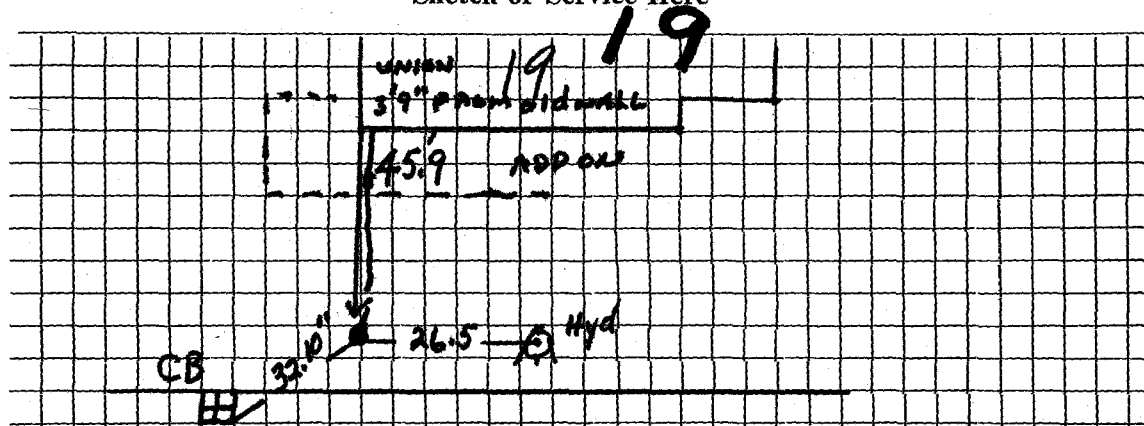

Connection made in Street. Work completed19

Remarks: ^{3/4"} UNION 3'9" FROM OLD WALL UNDER NEW ADDITION FLOOR BY OWNER