

Name Roger Miles

Service No. 114

Address 21 Woodland Road

Lexington, Mass.

Location 21 Woodland Road

Kind of Pipe

Size

Size of Main

~~REPAIR HIGHWAY~~ New Service

Com. 7-3-50

Location

Date	Material	Amount	Total	Date	Amount
June 8, '50	Labor	6 00	6 00	June 8, '50	50 00
	10% Overhead		60	July 20 '50	11 56
	60' - 3/4" Copper Tubing @.23		13 80		38 44
	1 - 3/4" C x 1/2" I.W.H. S&W		3 29	June 8, '50	13 40
	Littlefield Shovel 2 hrs. @7.00		14 00	12' - 3/4" Copper Tubing @.23	2 76
	Trucking 1 hr. @.75		75	1 - 3/4" C Corp-cock	3 15
11-1-62	Repair		38 44	1 - 3/4" C x 3/4" C Curb-cock	3 85
	32' 3/4" Copper			1 - Box & Rod	3 35
	1 3/4" 3 Part Union			1 - 1/2" Straight Tail Piece	38
				1 - 1/2" Offset Tail Piece	38
				Littlefield Shovel 1 hr. @ 7.00	7 00
				Trucking 1 hr. @.75	75
	Labor				35 02

DATE _____

TOWN OF LEXINGTON - BOARD OF PUBLIC WORKS

WATER DIVISION


The undersigned applies for a supply of water at No..... St. and hereby agrees to comply with the rules and regulations as now, or at any future time, established by the Board of Selectmen.

Am't of Estimate \$..... Owner

Am't Paid \$..... Address

Builder

Sketch of Service Here

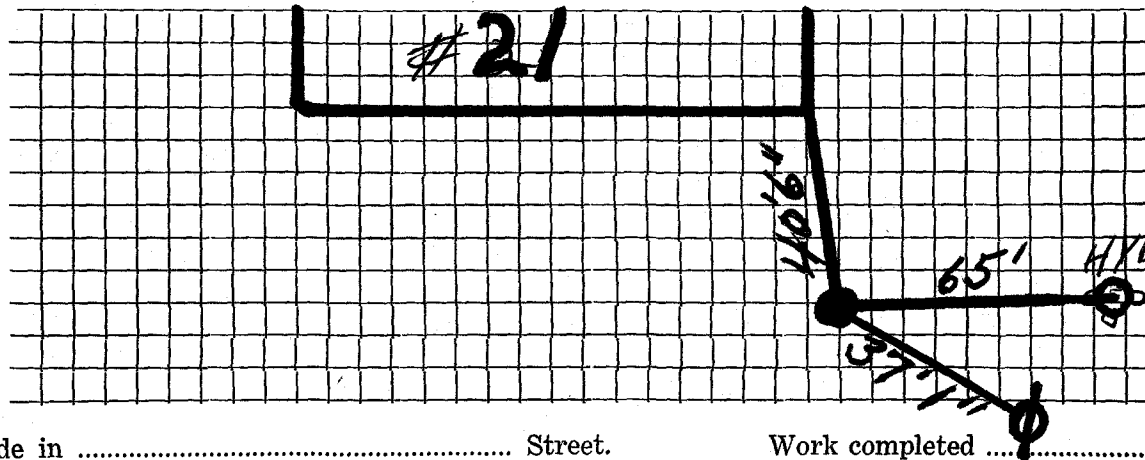

Connection made in Street. Work completed19

Remarks: