

WATER SERVICE RECORD

Name Harold E. Manning

Service No. 172

Address 28 Woodland Road

Location Lexington, Mass.

~~Repair~~—Renewal—~~New Service~~

COM.10-15-51


Date	Material	Amount	Total	Date	Amount
7-27-51	Labor	1 49	1 49	7-25-51	Deposited 40 00
	10% Overhead		15	10-15-51	Refunded 19 82
	1/2'-3/4" Copper Tubing @.320		13 09		No Charge 20 08
	1-3/4" Cx 1/2" I.W.H. S&W		4 00		
	1 Hr. Trucking		75	7-27-51	Labor 1 49
			20 08		
					30'-3/4" Copper Tubing 9 78
					1-3/4" C Corp-Cock 4 33
					1-3/4" Cx 3/4" C. Curb Cock 4 67
					1- Box & Rod 4 68
					1- 1/2 straight tail piece 50
					1- 1/2 offset tail piece 50
					1 Hr. Trucking 75
					<u>26 70</u>

DATE _____

TOWN OF LEXINGTON — BOARD OF PUBLIC WORKS

WATER DIVISION

Sketch of Service Here

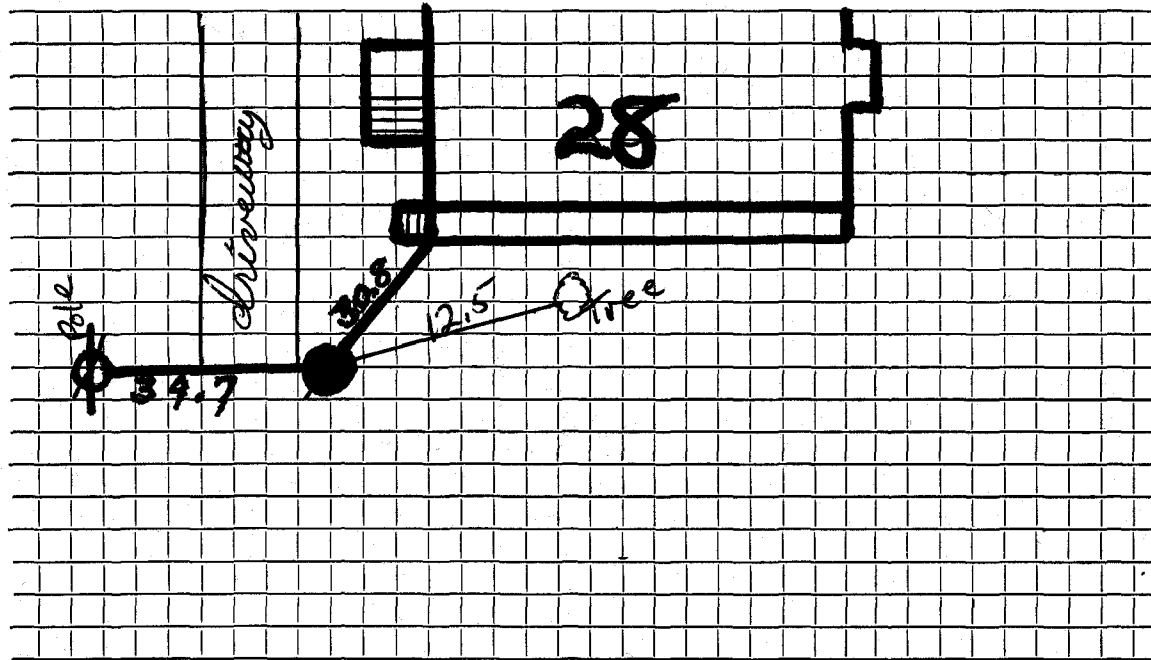

Connection made in Street. Work completed

Remarks:

.....

.....