

WATER SERVICE RECORD

Main to curb - Renewal

Name Harrell F. Beck

Service No. 150

Address 30 Woodland Road

1923

Location Lexington, Mass.

Repair - Renewal - ~~New Service~~ W.O. #7692


Comm 12-10-62

Date	Material	Amount	Total	Date	Material	Amount
11-2-62	Labor	58.71		10-29-62	Deposit	150.00
	10% O.H.	5.87	64.58	11-10-62	Re Smud	4.55
	35' 3/4" Copper tubing @42		14.70		<u>NON CHARGE</u>	164.45
1	3/4" CX 1/2 I.W.H. Stop & Waste		6.17	7/26/51	Labor	2.98
2	Hrs. Town Shovel @6.50		13.00	26'	3/4" copper tubing @.326	8.48
2	Hrs. Trucking @3.00		6.00	1	3/4" C. adapter	1.82
			104.45	1	3/4" C x 3/4" C. curb-cock	4.67
					1 box and rod	4.68
					1 hr. trucking	75
						23.38
				11-2-62	1 Curb Box & Rod	4.90
					1 1/2 Straight Tailpiece	.50
					1 1/2 Offset Tailpiece	.50
						29.28

DATE _____

TOWN OF LEXINGTON — BOARD OF PUBLIC WORKS
WATER DIVISION

Sketch of Service Here

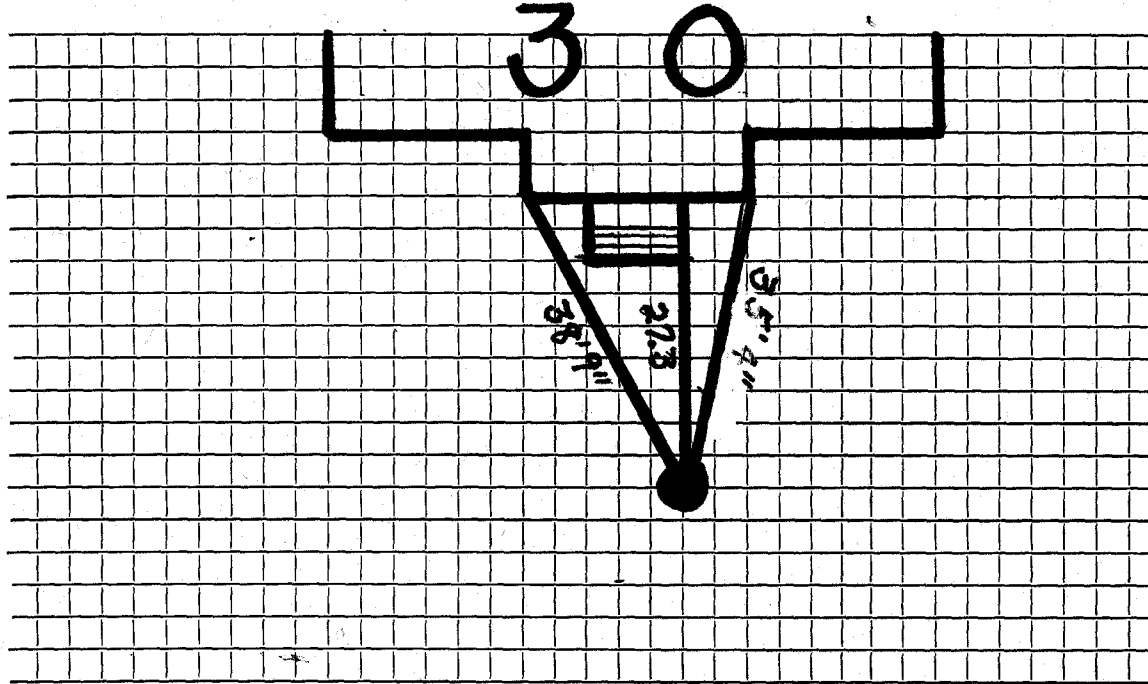

Connection made in Street. Work completed

Remarks: Tie Taken From old card

.....
.....