

Name E. C. Maguire

Service No. 101 3201

Address 31 Woodland Road

# 7039

Lexington, Mass.

Location 31 Woodland Road

Kind of Pipe

Size

Size of Main

~~Repair & Renewal~~ - New Service

*Com 12-30-46*

Location

Date	Material	Amount	Total	Date	Material	Amount
Nov. 6, '46	Labor	1 05	1 05	Nov. 1, '46	Labor	15 00
	10% Overhead		11	Dec. 31, '46	Labor	1 87
	35' - $\frac{3}{4}$ " Copper Tubing @.24		8 40		Non-Charge	13 13
	1 - $\frac{3}{4}$ " C x $\frac{1}{2}$ " I.W.H. S & W		2 82	Nov. 5, '46	Labor	10 45
	Trucking 1 hr. @.75		75	6, '46	"	25 20
			13 13	14' - $\frac{3}{4}$ " Copper Tubing @.24		8 40
	<u>Trench Dug By Owner</u>			1 - $\frac{3}{4}$ " C Corp-cock		2 70
				1 - $\frac{3}{4}$ " C x $\frac{3}{4}$ " C Curb-cock		3 30
				1 - Box & Rod		3 50
				Dynamite 3 lbs. @.12		36
				Exploders 5 @.10		50
				Compressor 2 hrs. @1.75		3 50
	Labor			Trucking 1 hr. @.75		75
				1 - $\frac{1}{2}$ " Offset Tail Piece		50
				1 - $\frac{1}{2}$ " Straight Tail Piece		50
						54 62

Hadley Press, Inc., Lexington

DATE \_\_\_\_\_

# TOWN OF LEXINGTON—BOARD OF PUBLIC WORKS

## WATER DIVISION

The undersigned applies for a supply of water at No. \_\_\_\_\_ St. and hereby agrees to comply with the rules and regulations as now, or at any future time, established by the Board of Selectmen.


Am't. of Estimate \$ \_\_\_\_\_

Owner \_\_\_\_\_

Am't. Paid \$ \_\_\_\_\_

Address \_\_\_\_\_

Builder \_\_\_\_\_

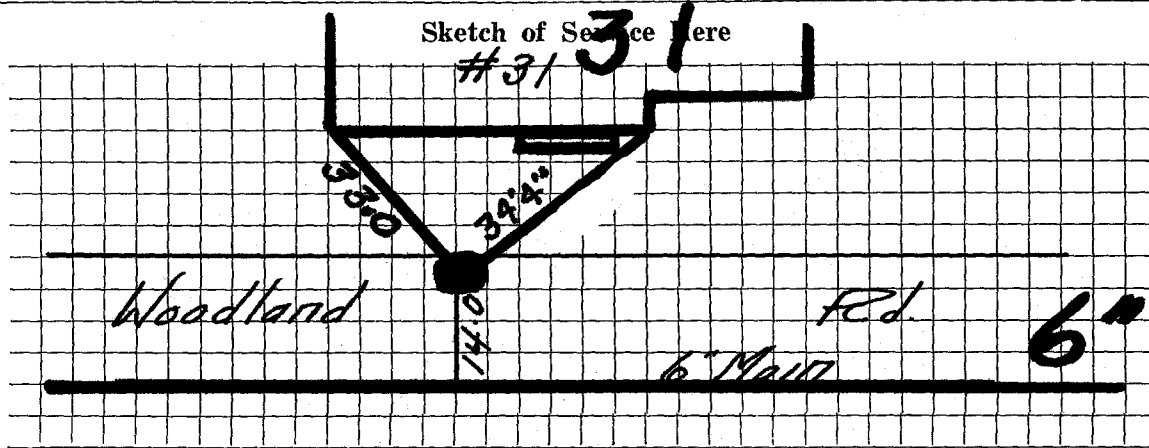

Connection made in \_\_\_\_\_ Street.

Work completed \_\_\_\_\_ 19

Remarks: