

Name Merton S. Barrows

Service No. 3061

Address 40 Windsor Street, Arlington, Mass.

#4527

35 WOODLAND RD.

Location

Lot 29 Woodland Road.

Kind of Pipe

Size

Size of Main

Repair—Renewal—New Service

Location

Date
1939

Material

Amount

Total

Date

Amount

Nov. 23,

10 hrs. @ 60¢

6 00

7 30

November 16, 1939 Deposited

15 00

2 " @ 65¢

1 30

January 16, 1940 Paid

1 43

32' 3/4" Copper Tubing @ 15¢

4 80

1 3/4" C.x 1/2" I.S. & W.

2 10

Trucking 2 hrs. @ 75¢

1 50

15 70

10% Overhead on labor

73

\$16 43

Bill 143 cent 11/1/39

Labor

DATE Sept 29, 1935

TOWN OF LEXINGTON—BOARD OF PUBLIC WORKS

WATER DIVISION

The undersigned applies for a supply of water at No. Lot #29 ^{#35} Woodland Road St. and hereby agrees to comply with the rules and regulations as now, or at any future time, established by the Board of Selectmen.

Am't. of Estimate \$ 15.00

Owner Merton S. Barrows


Am't. Paid \$ _____

Address 40 Windsor St.

Builder _____

Arlington

Sketch of Service Here

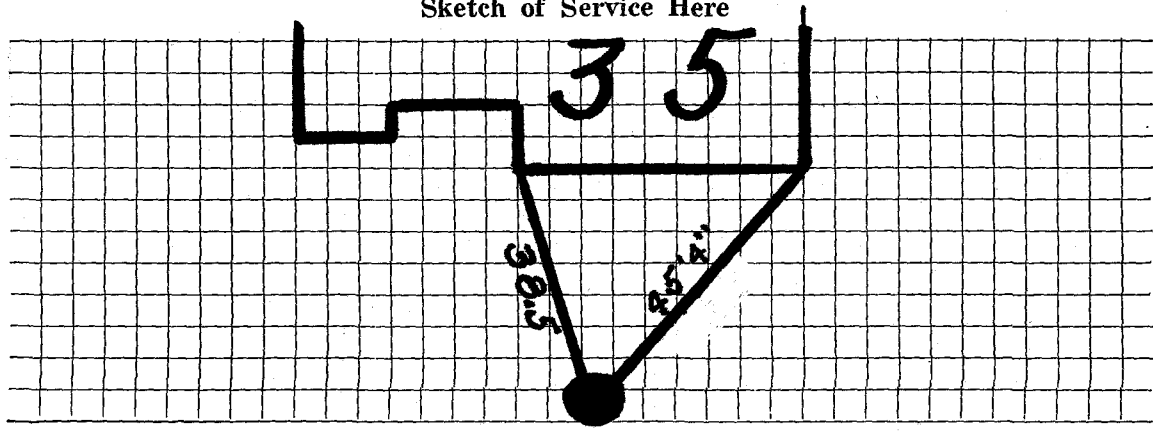

Connection made in _____ Street.

Work completed _____ 19

Remarks: