

WATER SERVICE RECORD

Name Col/ Gerard B. Troland

Service No. 85

Address 36 Woodland Street

Location

~~Repair~~ Renewal - New Service

W. O. # 361

FEB 12 1973


Date		Material	Amount	Total	Date	Amount
12/8/72		Labor	67 20		12/7/72	Deposit 175 00
		10% O.H.	6 72	73 92	2/12/73	Refund 24 52
	45'	3/4" Copper pipe .79		35 55	8-7-51	Renewal 150 48
	1	3/4 x 1/2 C. I. Wheel Handle		12 01	30'	3/4" Copper
	1	Yd. Loam		3 50		1 3/4" C. Adapter
	3	Hrs. Shovel 6.50		19 50		1 3/4" C. X 3/4" Curb Cock
	2	Hrs. Trucking 3.00		6 00		
				150 48		

DATE _____

TOWN OF LEXINGTON — BOARD OF PUBLIC WORKS

WATER DIVISION

Sketch of Service Here

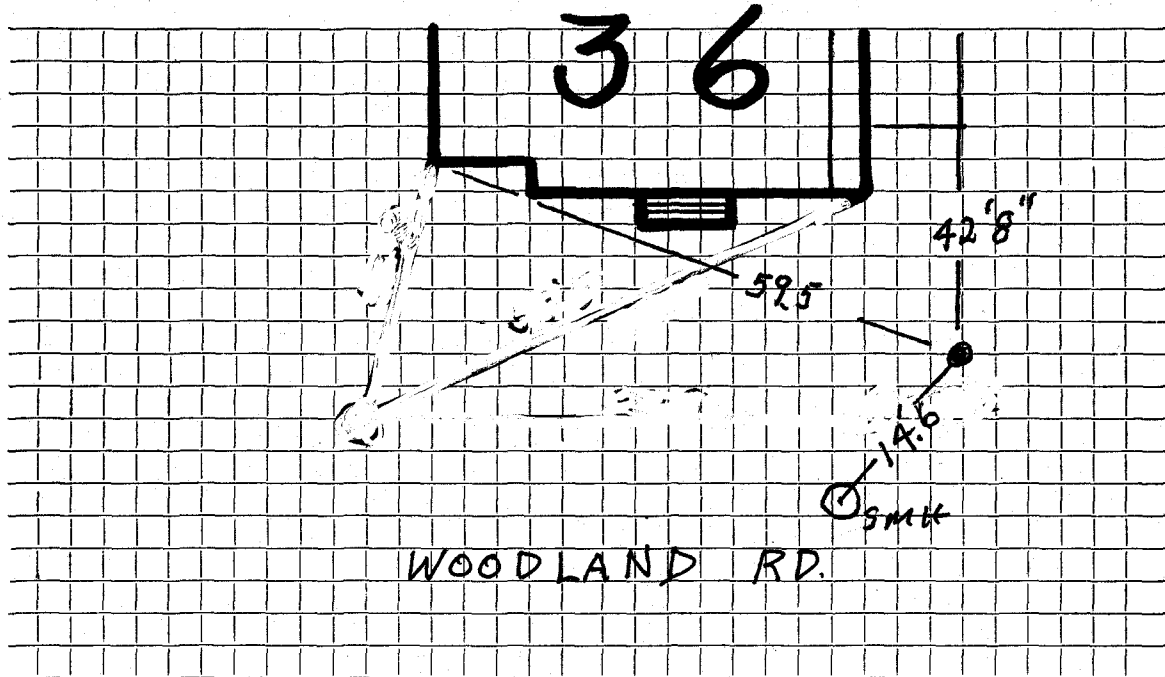

Connection made in Street. Work completed

Remarks:

.....

.....