

WATER SERVICE RECORD

Name Robert Erickson

Service No. 90

Address 4 Woodland Road

Location

~~Repair~~ New Service


Comm 9-25-61

Date	Material	Amount	Total	Date	Amount	
7-17-61	Labor	2.32		7-5-61	Deposit	50.00
	10% O.H.	.23	2.55	9-25-61	Refund	16.08
60'	3/4" Copper Tubing @.42		25.20			33.92
1	3/4" C x 1/2 I.WH. Stop & Waste		6.17			
			33.92		NON CHARGE	
				7-18-61	Labor	50.05
				5'	3/4" Copper Tubing @.42	2.10
				2	3/4" C 3 part unions @2.414	4.82
				2	Hrs. Town Shovel @6.50	13.00
				3	x \$ Patch	5.00
						74.97

DATE _____

TOWN OF LEXINGTON — BOARD OF PUBLIC WORKS
WATER DIVISION

Sketch of Service Here

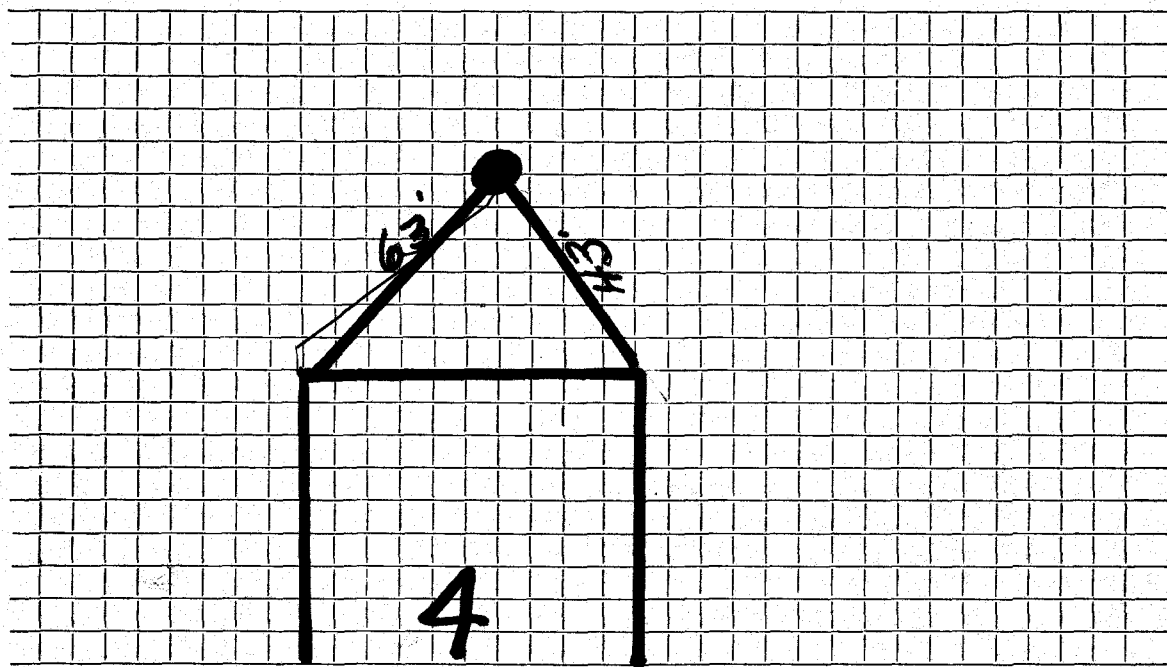

Connection made in Street. Work completed

Remarks:
.....
.....