

Name Andrew Sandgren

#2828

Service No. ⁶⁴ 3301

Address 40 Woodland Road

Lexington, Mass.

Location 40 Woodland Road

Kind of Pipe

Size

Size of Main

~~Repair/Repair~~ - New Service

Location

Date	Material	Amount	Total	Date	Amount
Jul. 15, '47	Labor	15 20		July 12 '47	40.00
16	"	4 66	19 86		
	10% Overhead		1 99		Non-Charge
	52' - 3/4" Copper Tubing @.27		14 04	Jul. 16, '47	Labor 15 17
	1 - 3/4" C x 1/2" I.W.H. S & W		3 15		10' - 3/4" Copper Tubing @.27 2 70
	Trucking 1 hr. @.75		75		1 - 3/4" C Corp-cock 3 00
			39 79		1 - 3/4" C x 3/4" C Curb-cock 3 68
					1 - Box & Rod 4 26
					1 - 1/2" Straight Tail Piece 30
					1 - 1/2" Offset Tail Piece 30
					Trucking 1 hr. @.75 75
					30 16
	Labor				

Stamped bill sent 9-16-49

Hadley Press, Inc., Lexington

DATE _____

TOWN OF LEXINGTON—BOARD OF PUBLIC WORKS

WATER DIVISION

The undersigned applies for a supply of water at No. _____ St. and hereby agrees to comply with the rules and regulations as now, or at any future time, established by the Board of Selectmen.

Am't. of Estimate \$ _____

Owner _____


Am't. Paid \$ _____

Address _____

31 Meriden Street

Builder _____

Sketch of Service Here

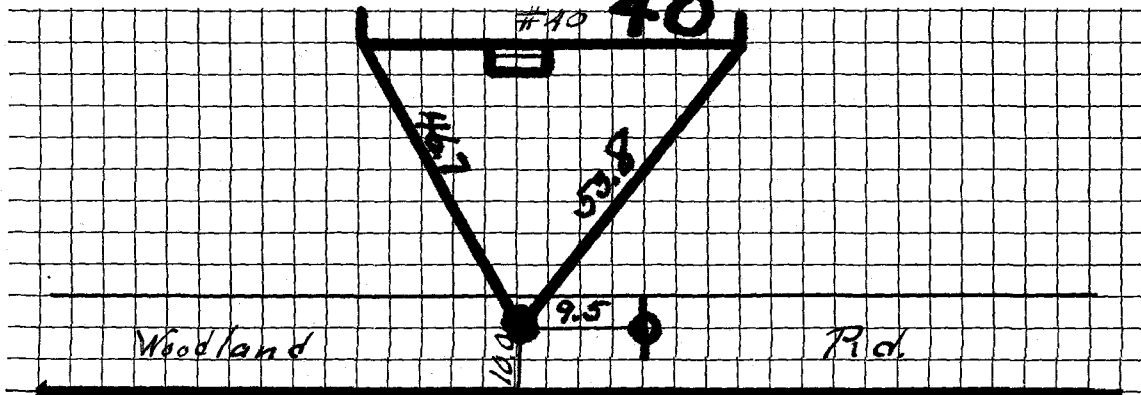

Connection made in _____ Street.

Work completed _____ 19

Remarks: