

Name Walter G. Black

Service No. 48 3064

Address Highland Avenue

#43 Woodland Rd

#9117

43 WOODLAND RD.

Location

Donald C. Mark

Woodland Road

Kind of Pipe

Size

Size of Main

~~REPAIRS~~ - New Service

Location

Date	Material	Amount	Total	Date	Amount
10/29/34	72' 1" C. Pipe @ .21	15 12			
11-27-34	1' 1" C. Union	85			
mm-32-40	Trucking	75	316 72	Oct. 26/1934 - Cash	27 -
A Russell				May 26 1936	37 40
					32 40
	3 Hours Labor @ .85	1 85			
	2 " " @ .60	1 20	2 35		
	10' Overhead		29		
			19 38		
COST					
CHARGE	72' @ .45	32 40	32 40		
	Labor				

Hay Press, Inc., Lexington

Owner to dig own trench ~~to lay service pipe~~

DATE October 26, 1934

60 Feet

TOWN OF LEXINGTON—BOARD OF PUBLIC WORKS
WATER DIVISION

The undersigned applies for a supply of water at No. 81 Woodland Road St. and hereby agrees to comply with the rules and regulations as now, or at any future time, established by the Board of Selectmen.

Am't. of Estimate \$ 27.00

Owner Donald C. Wark, S.D.


Am't. Paid \$ _____

Address _____

Builder W. B. Black

Belmont, Mass.

Sketch of Service Here

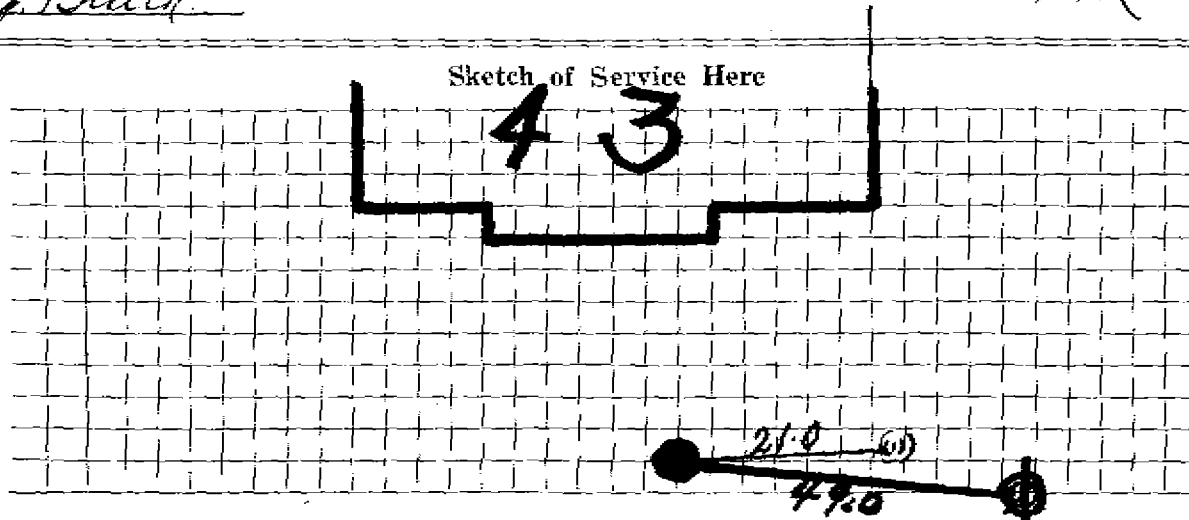

Connection made in _____ Street. Work completed _____ 19

Remarks: