

Name

Service No. 3065

Address

Location *46 Woodland Road*

Kind of Pipe

Size

Size of Main

Repair—Renewal—New Service

Location

Date

Material

Amount

Total

Date

Amount

Labor

Hadley Press, Inc., Lexington

DATE _____

TOWN OF LEXINGTON—BOARD OF PUBLIC WORKS

WATER DIVISION

The undersigned applies for a supply of water at No. _____ St. and hereby agrees to comply with the rules and regulations as now, or at any future time, established by the Board of Selectmen.

Am't. of Estimate \$ _____

Owner

J. J. Brown


Am't. Paid \$ _____

Address

46 Woodland Rd

Builder _____

Sketch of Service Here

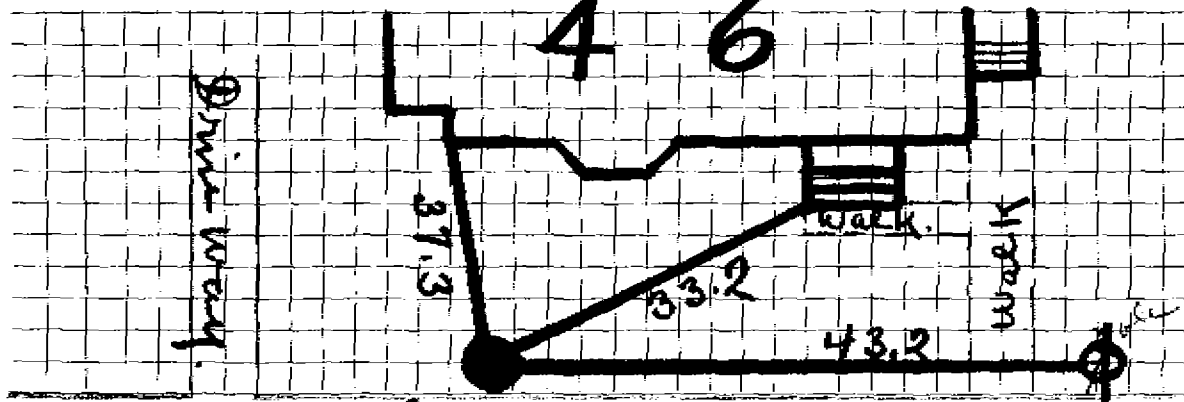

Connection made in Woodland Street Rd Work completed _____ 19

Remarks: