

Name Margaret Boston

Service No.

#18 3392

Address 8 Woodland Road

#5202

Location 8 Woodland Road

#7074

Kind of Pipe

Size

Size of Main

~~Renewal~~ Renewal—New Service *Com 12 1-47*

Location

Date	Material	Amount	Total	Date	Amount
Oct. 17, '47	Labor	4 40	4 40	Oct. 16 '47	35 00
	10% Overhead		44	Dec. 4 '47	2 90
	36' - 3/4" Copper Tubing @ .26		9 36		32 10
	1 - 3/4" C x 1/2" I.W.H. S & W		3 15		
	Shovel 2 hrs. @ 7.00		14 00	Oct. 17, '47	5 27
	Trucking 1 hr. @ .75		75	17' - 3/4" Copper Tubing @ .26	4 42
			32 10	1 - 3/4" C Corp-cock	3 00
				1 - 3/4" C x 3/4" C Curb-cock	3 68
				1 - Box & Rod	4 26
				1 - 1/2" Straight Tail Piece	30
				1 - 1/2" Offset Tail Piece	30
				Trucking 1 hr. @ .75	75
					21 98
	Labor				

DATE \_\_\_\_\_

# TOWN OF LEXINGTON - BOARD OF PUBLIC WORKS

## WATER DIVISION

The undersigned applies for a supply of water at No..... St. and hereby agrees to comply with the rules and regulations as now, or at any future time, established by the Board of Selectmen.

Am't of Estimate \$.....

Owner .....


Am't Paid \$.....

Address .....

Builder .....

*59 Cottage St Somerville*

Sketch of Service Here

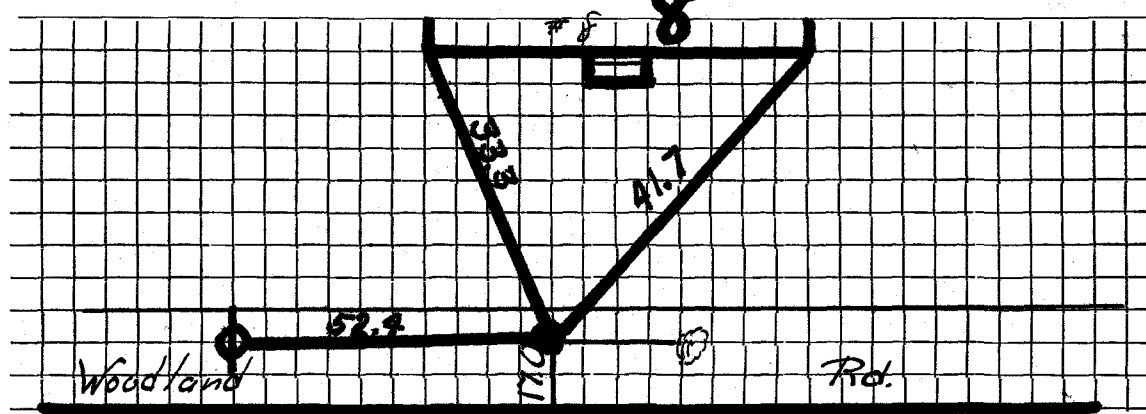

Connection made in ..... Street.

Work completed .....19

Remarks: