

WATER SERVICE RECORD

Name

Service No.

Address 10 Woodport Circle

Location

Repair—Renewal—New Service


Date	Material	Amount	Total	Date	Amount
76	① corp.				
	① clatport (union 20ft. from base)				
	① union				
	97ft. 1" copper				
89	Repair union				

DATE _____

TOWN OF LEXINGTON — BOARD OF PUBLIC WORKS

WATER DIVISION

Sketch of Service Here

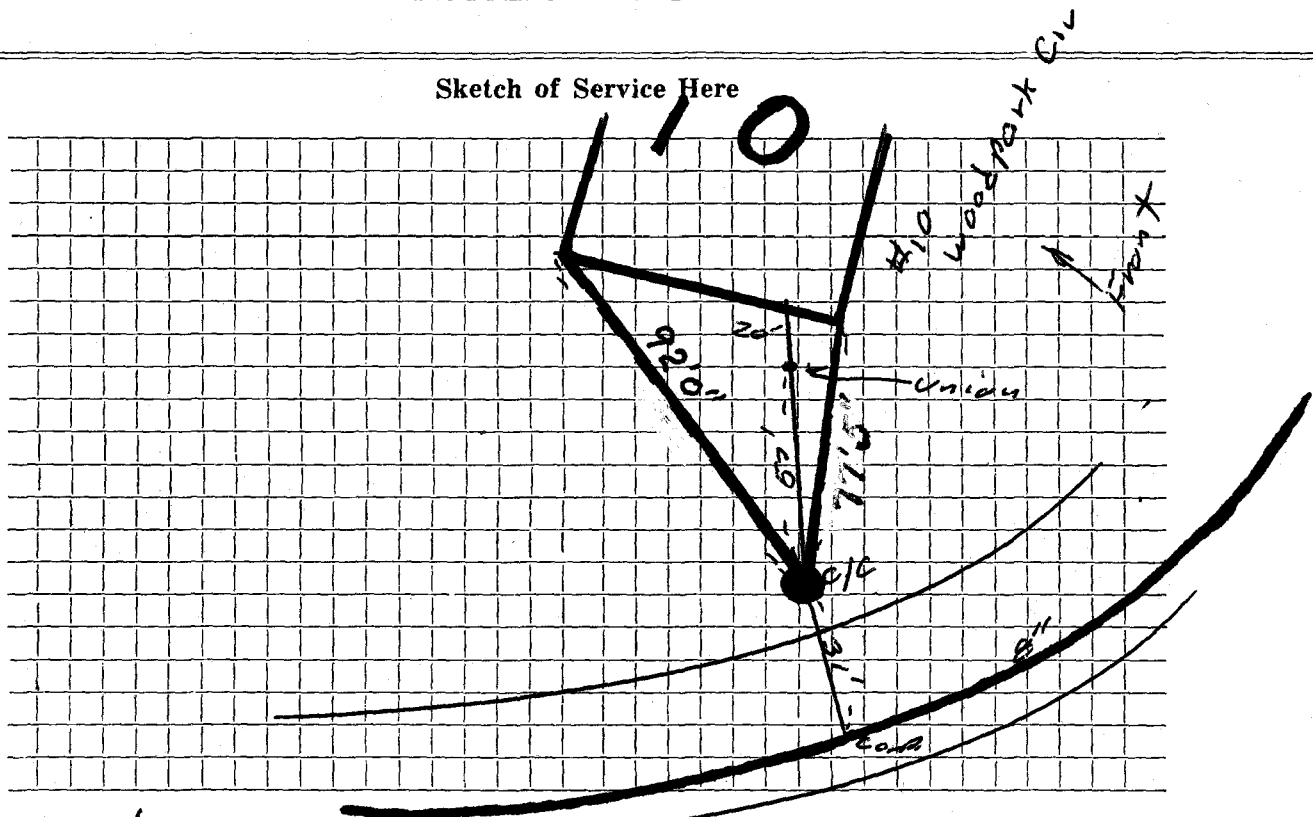

Connection made in Woodpark Cir Street Work completed

Remarks:

.....

.....