




DATE \_\_\_\_\_

TOWN OF LEXINGTON — BOARD OF PUBLIC WORKS

WATER DIVISION

Sketch of Service Here **12**

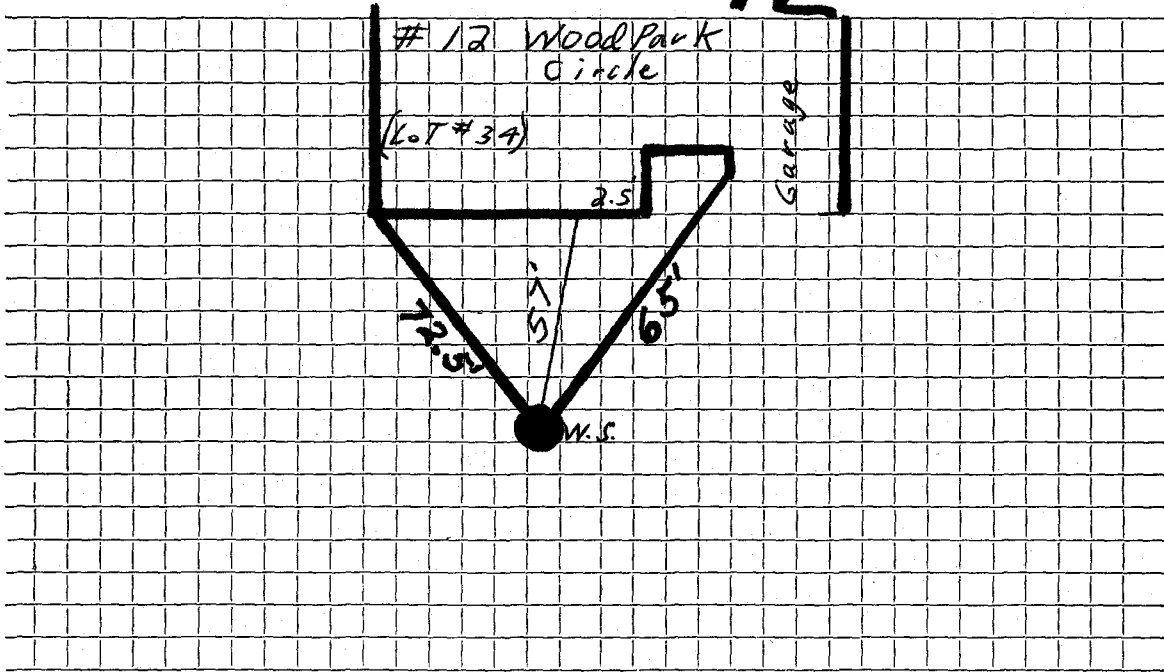

Connection made in ..... Street. Work completed .....

Remarks: .....

.....

.....