


TOWN OF LEXINGTON — BOARD OF PUBLIC WORKS

WATER DIVISION

13
Sketch of Service Here

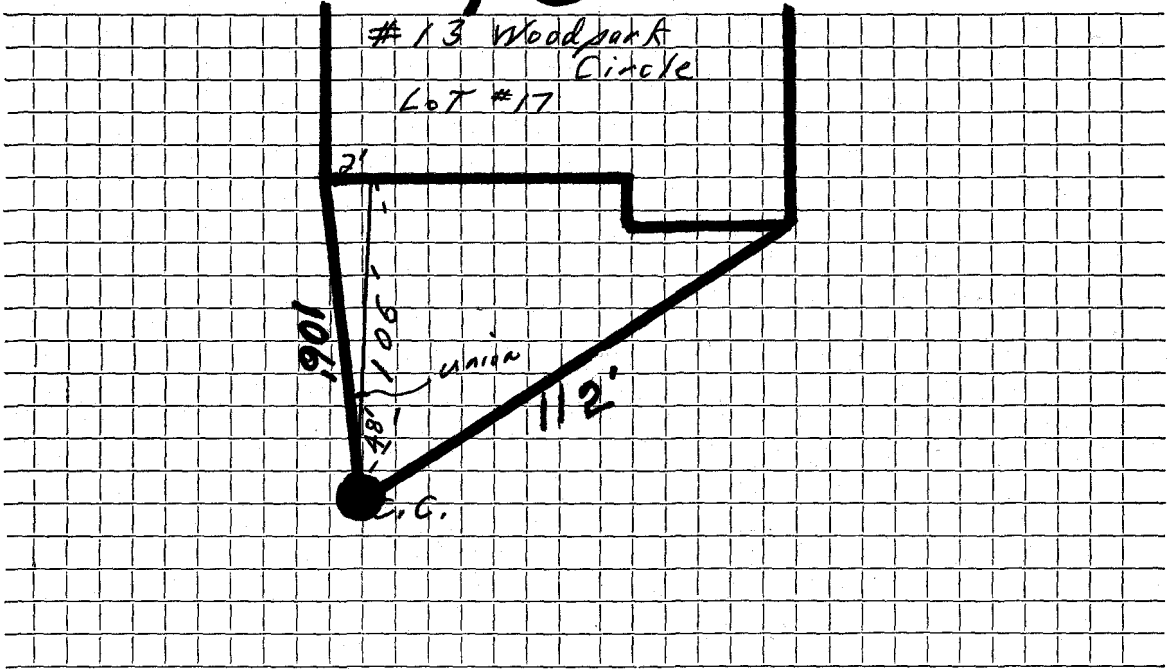

Connection made in Woodpark Circle ~~Street~~

Work completed

Remarks:
.....
.....