


DATE _____

TOWN OF LEXINGTON — BOARD OF PUBLIC WORKS

WATER DIVISION

19
Sketch of Service Here

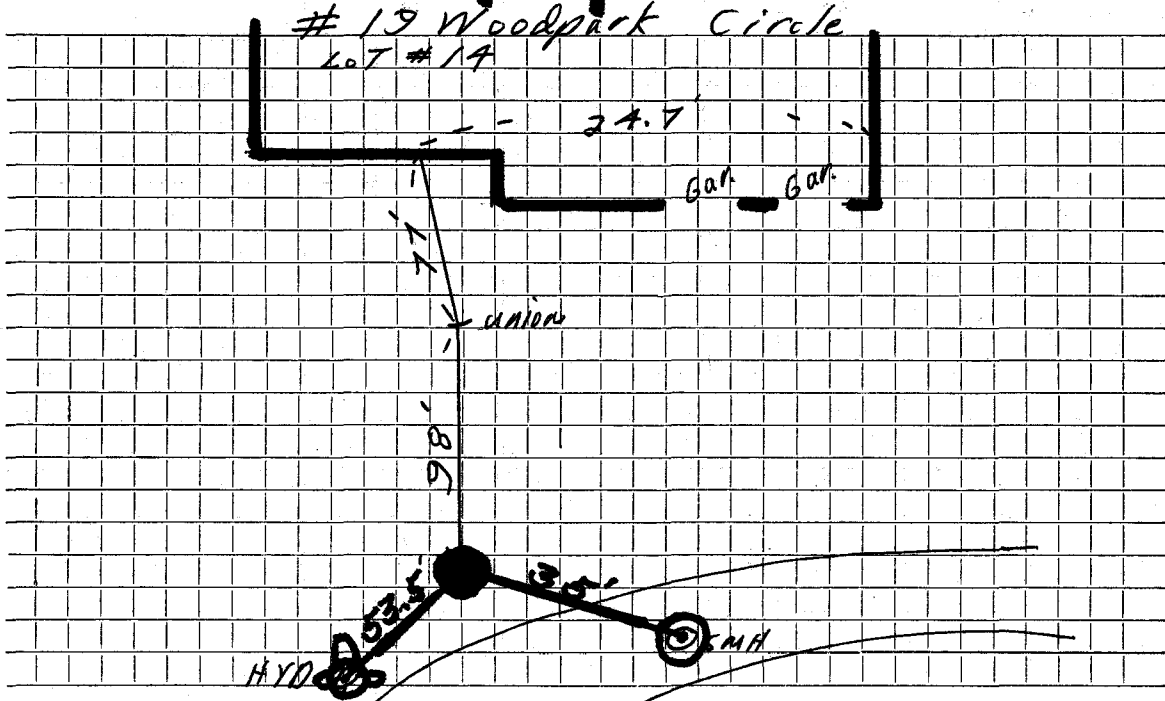

Connection made in Woodpark Circle Street. Work completed

Remarks:
.....
.....