


TOWN OF LEXINGTON — BOARD OF PUBLIC WORKS
WATER DIVISION

Sketch of Service Here
28

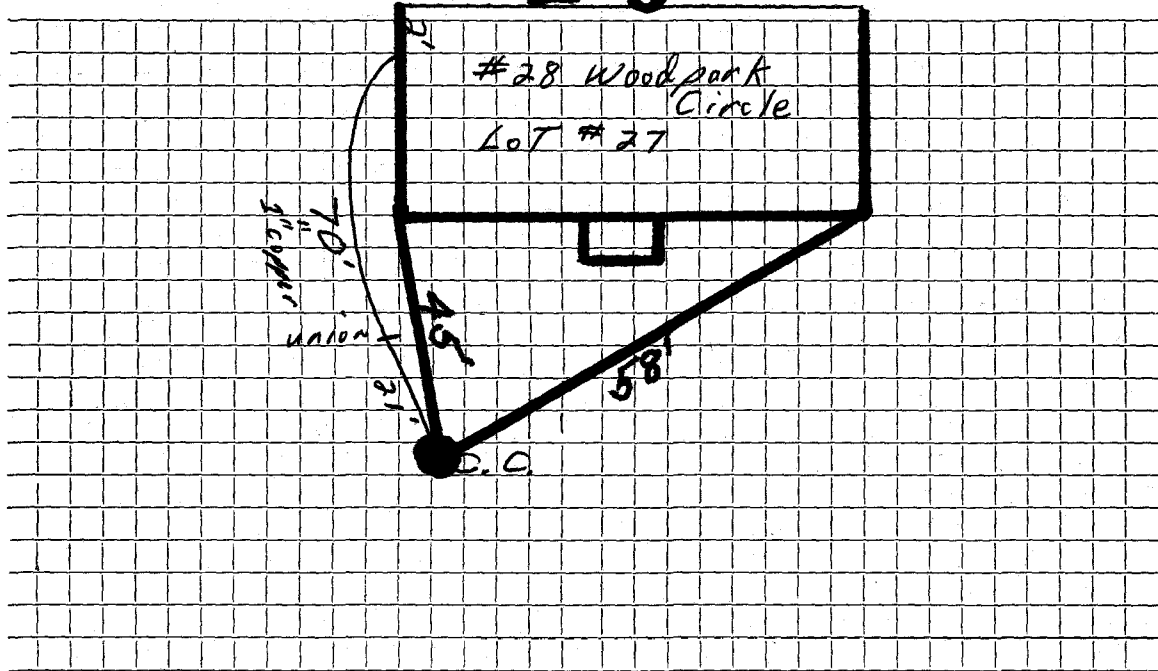

Connection made in Woodpark... Circle... Street.

Work completed

Remarks:
.....
.....