


DATE _____

TOWN OF LEXINGTON — BOARD OF PUBLIC WORKS

WATER DIVISION

Sketch of Service Here **32**

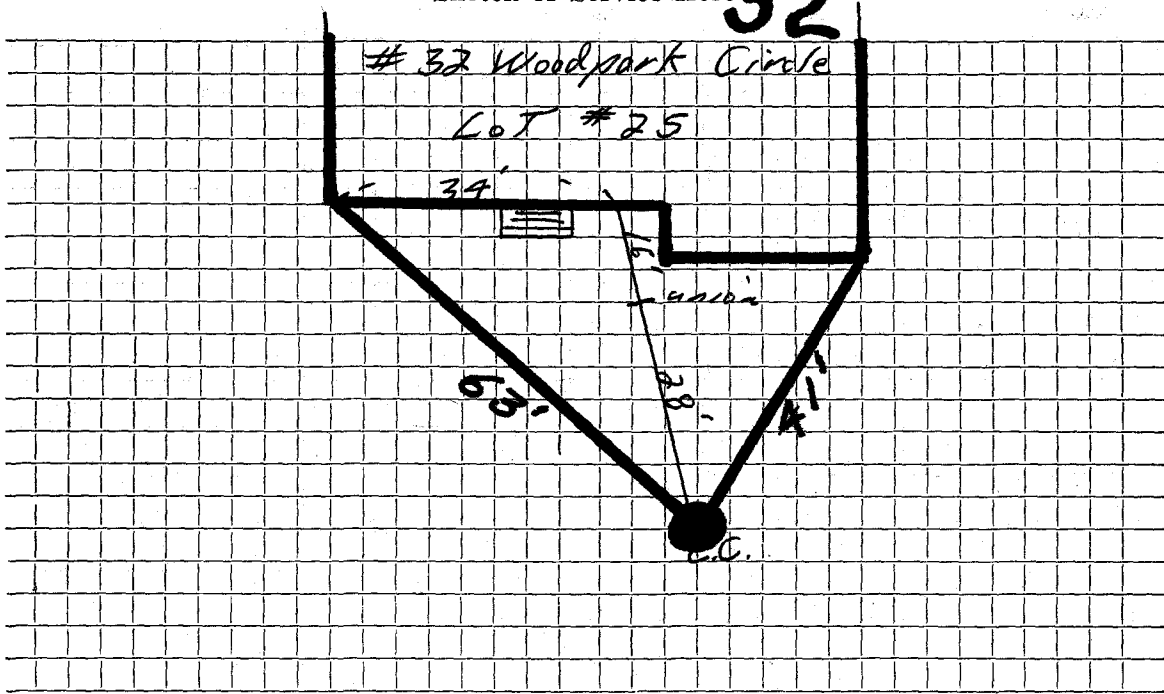

Connection made in Woodpark Circle ~~Street~~.

Work completed

Remarks:
.....
.....