


DATE _____

TOWN OF LEXINGTON — BOARD OF PUBLIC WORKS

WATER DIVISION

Sketch of Service Here

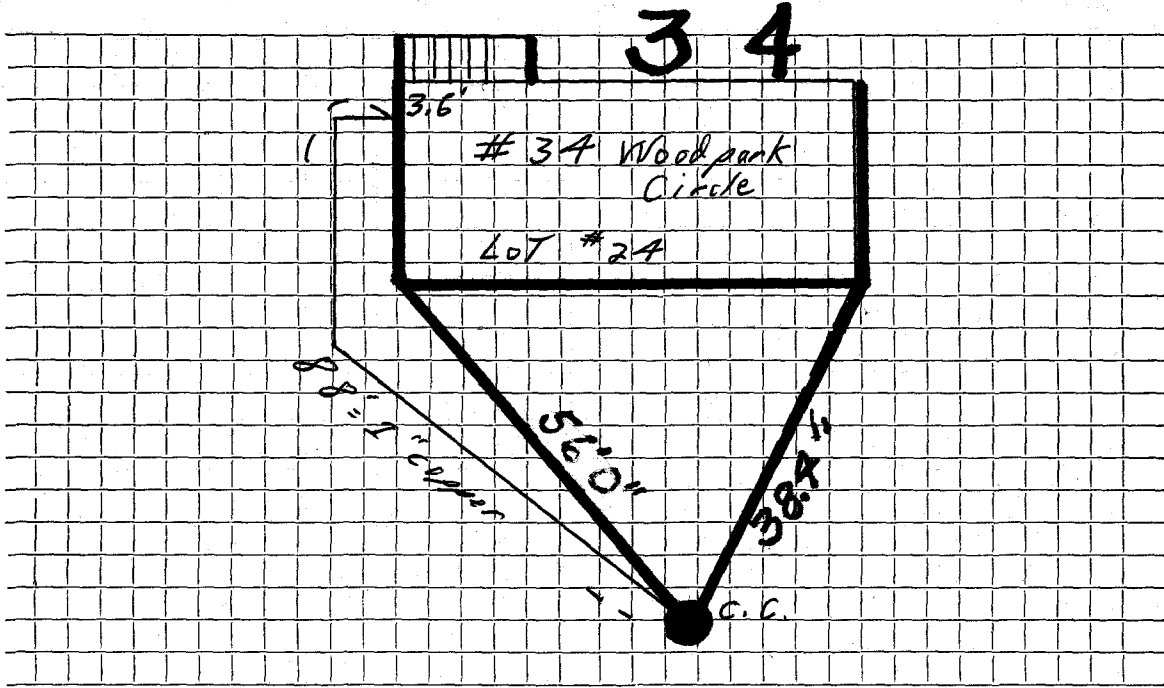

Connection made in Wood park Circle ~~Street~~. Work completed

Remarks:
.....
.....