


DATE _____

TOWN OF LEXINGTON -- BOARD OF PUBLIC WORKS

WATER DIVISION

Sketch of Service Here

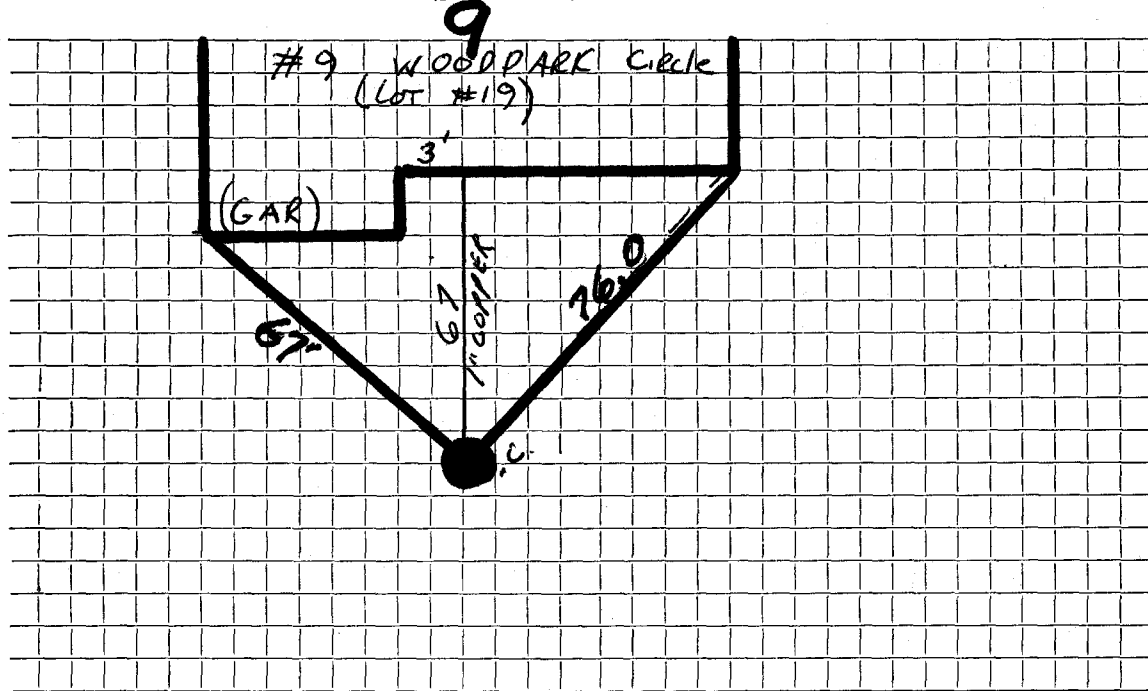

Connection made in WOODPARK CIRCLE Street. Work completed

Remarks:
.....
.....