




DATE 8/3/12

TOWN OF LEXINGTON — BOARD OF PUBLIC WORKS

WATER DIVISION

118 Worthen

Sketch of Service Here

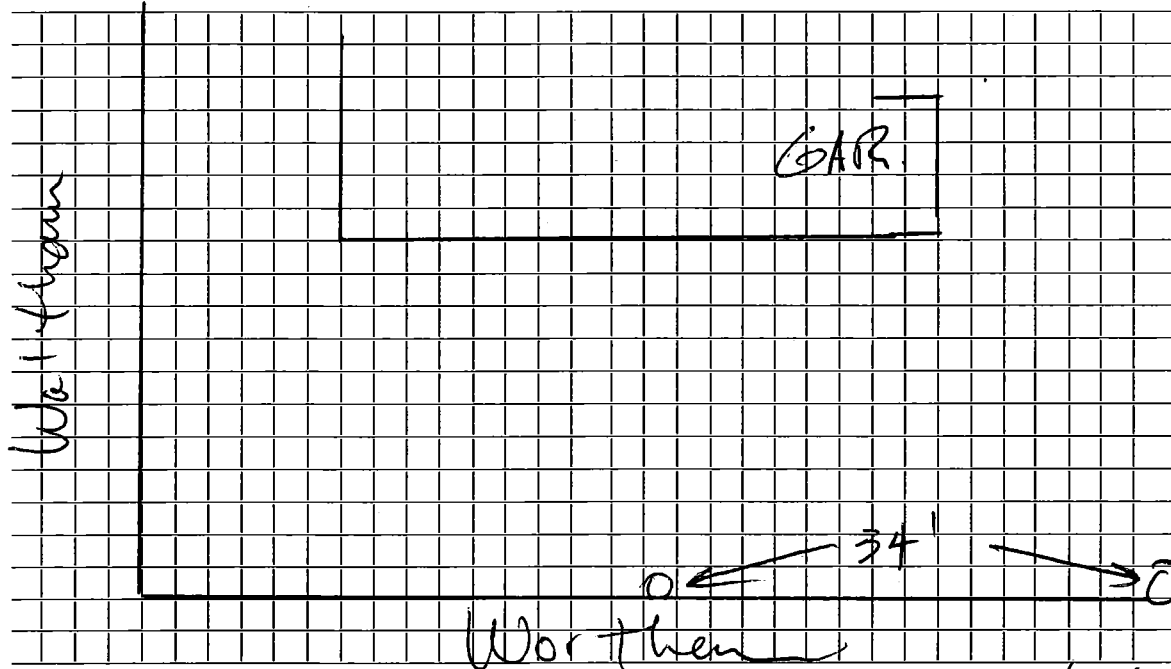

Connection made in Worthen Street. Work completed 8/3/12

Remarks: 6' + Cover

W. Flanagan