

WATER SERVICE RECORD

6743

2138
Service No. 120

Name Robert Hayes

Address 133 Worthen Road

Location Lot 68

~~XXXXXXXXXXXX~~ New Service

W.O.# 8263


Comm 2-10-64

Date	Material	Amount	Total	Date	Amount	
8-22-60	Labor	1 94		10-24-63	Deposit	100 00
	10% O.H.	19	2 13	2-10-64	Refund	36 35
	12' 3/4" Copper tubing		17 64			63 65
	<i>Bibb When Connected</i>		19 77			
10/31/63	Labor	4 73			NON CHARGE	
	10% O.H.	47	5 20	8-22-60	Labor	1 94
	60' 3/4" Copper Tubing @ .42		25 20	29	3/4" Copper tubing	12 18
	1 3/4" C3 Part Unions		2 41	1	3/4" C Corp Cock	4 64
	1 3/4" Cx 1/2 I.W.H. Stop & Waste		6 17	1	3/4" C Curb Cock	6 03
	1 Bow & Rod		4 90	1	Box & Rod	5 00
	PREVIOUS CHARGE		19 77			29 79
			63 65		1 1/2 Straight Tailpiece	50
					1 1/2 Offset Tailpiece	50
						30 79

TOWN OF LEXINGTON — BOARD OF PUBLIC WORKS

WATER DIVISION

Sketch of Service Here

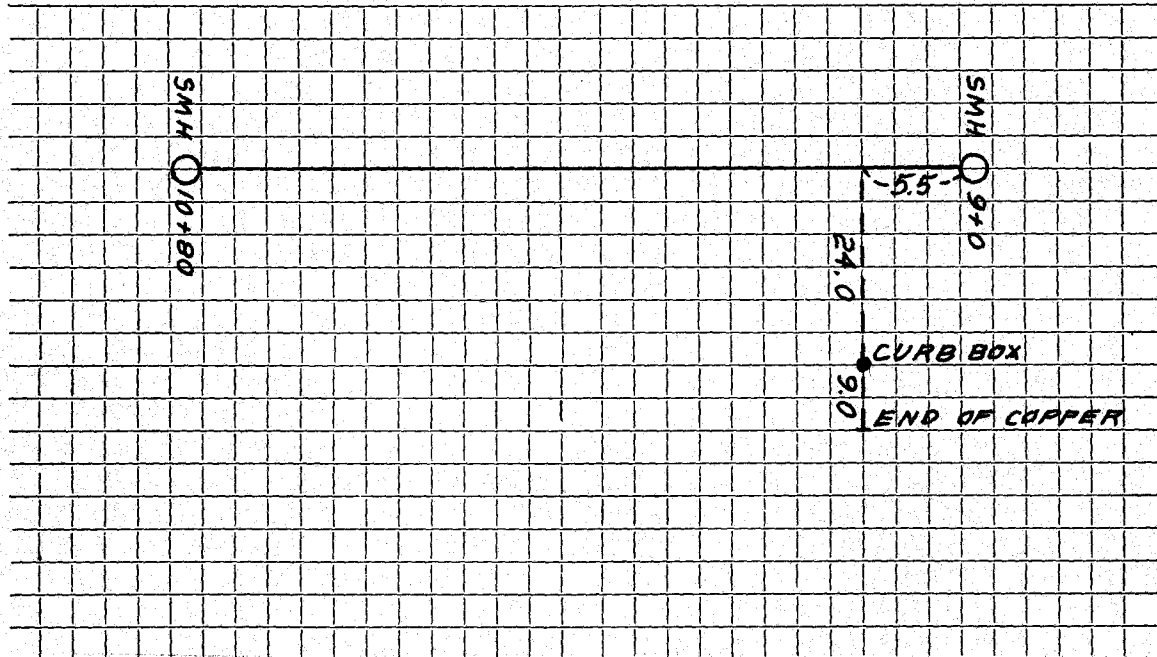

Connection made in Street. Work completed

Remarks:

.....

.....