

## WATER SERVICE RECORD

Name John E. Lundquist

Service No. 138

Address 134 Worthen Road

Location Lot 45

Repaired ~~Replaced~~ - New Service

WO# 8333


MAR 23 1964

Date	Material	Amount	Total	Date	Amount	
8-22-60	Labor	1 94		11-21-63	Deposit	75 00
	10% O.H.	19	2 13	3-23-64	Retaind	29 29
	12' 3/4" Copper tubing		5 04			45 71
	<i>Bill when connected</i>		7 17			
12/6/63	Labor	2 42			NON CHARGE	
	10% overhead	24	2 66	8-22-60	Labor	1 94
	65' 3/4" Copper tubing @ .42		27 30		10' 3/4" Copper tubing	4 20
	1 3/4" C x 1/2 I.W.H. Stop & Waste		6 17		1 3/4" C Corp Cock	4 64
	1 3/4" C 3-part Union		2 41		1 3/4" C Curb Cock	6 03
			45 71		1 Box & Rod	5 00
						21 81
				12/6/63	1 1/2 Straight tailpiece	50
					1 1/2 Offset tailpiece	50
						22 81

TOWN OF LEXINGTON — BOARD OF PUBLIC WORKS

WATER DIVISION

Sketch of Service Here

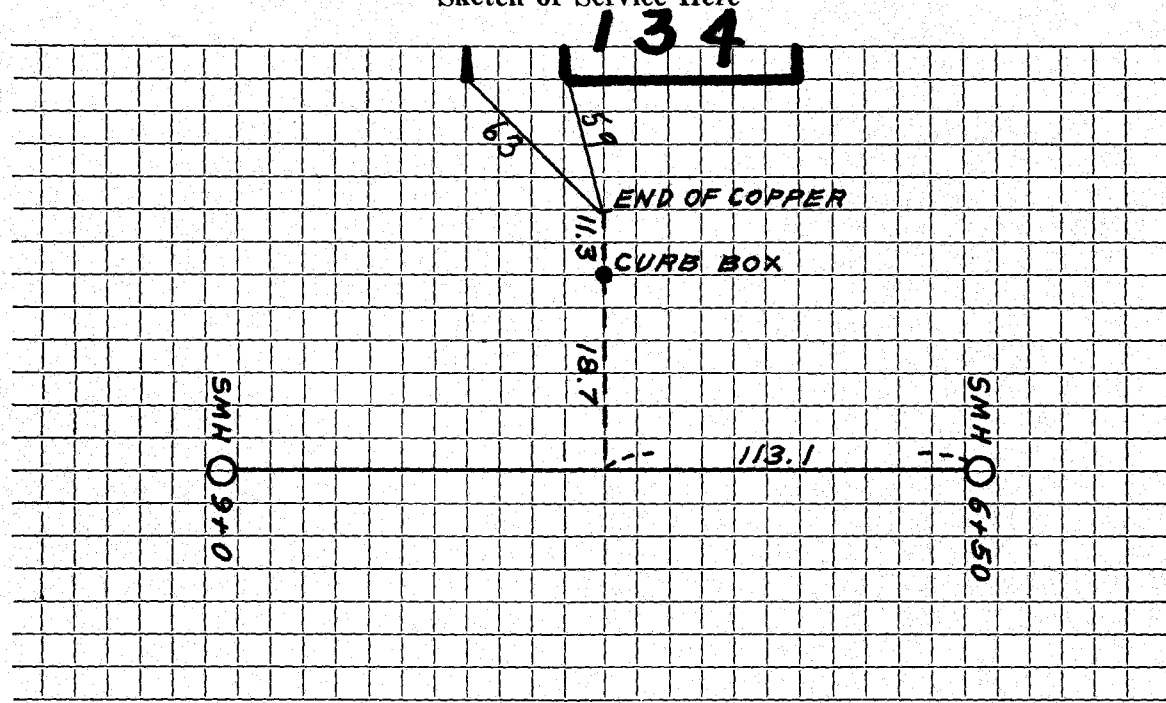

Connection made in ..... Street. Work completed .....

Remarks: .....  
.....  
.....