




Date: 7/12/22

TOWN OF LEXINGTON - BOARD OF PUBLIC WORKS  
~~WATER~~ SEWER DIVISION

SKETCH OF SERVICE HERE

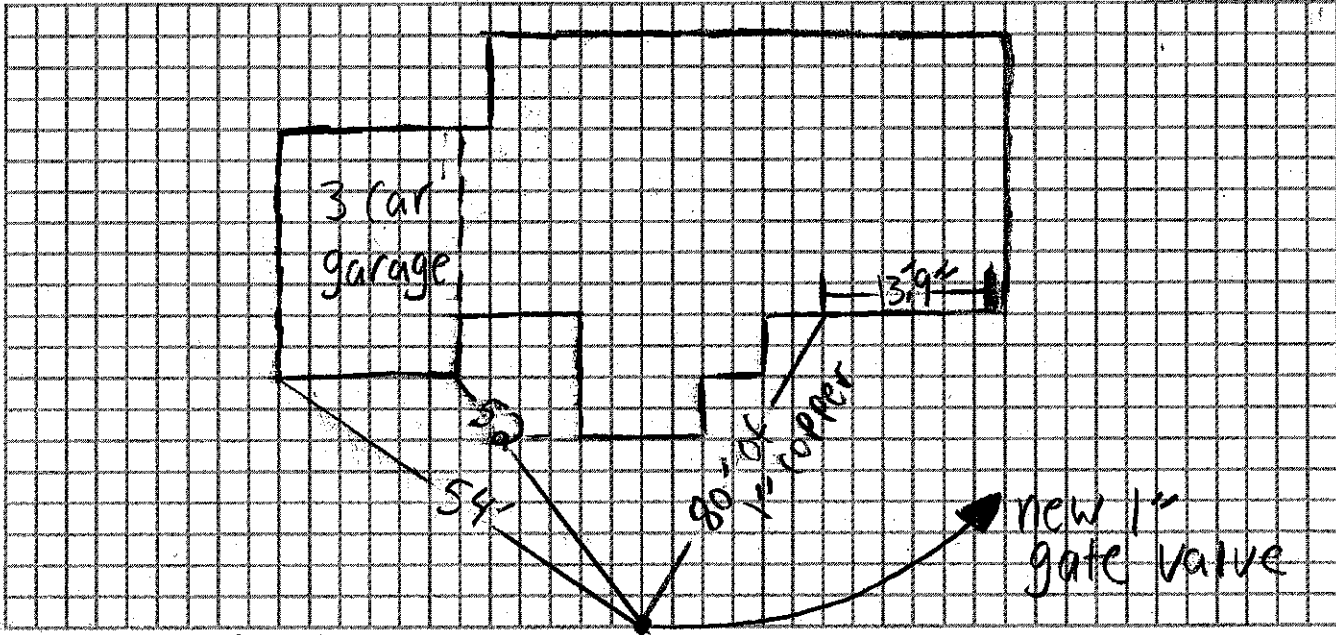

Connection made in: 135 Worthen Rd Street.

Work completed:

Remarks: INSTALLED By McLAUGHLIN