




# TOWN OF LEXINGTON — BOARD OF PUBLIC WORKS

## WATER DIVISION

Sketch of Service Here

# 138

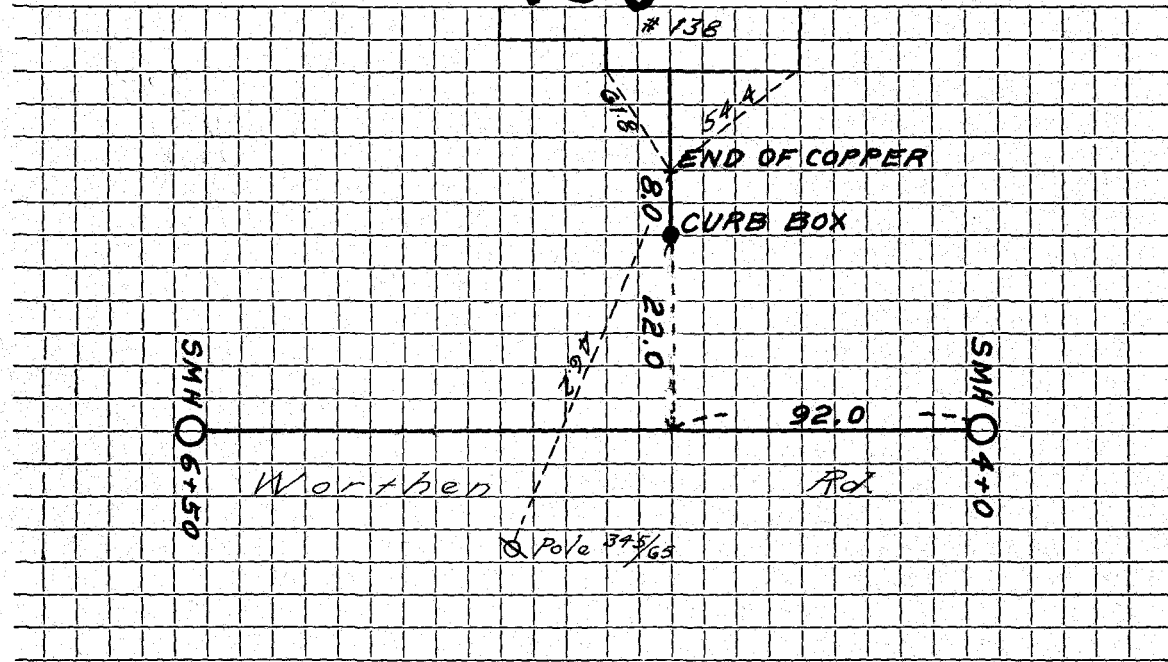

Connection made in ..... Street. Work completed .....

Remarks: .....  
.....  
.....