

6652

WATER SERVICE RECORD

Name Louis Ciampa

Service No. 134

Address Worthen Road 140

Location Lot 42

~~REPAIR WORK~~ - New Service DeFlice Bros - Permit #153

FEB 15 1965

Date	Material	Amount	Total	Date	Amount	
8-22-60	Labor	1 94		11-5-64	Deposit	27 45
	10% O.H.	<u>19</u>	2 13			
8'	3/4" Copper tubing		<u>2 94</u>			
			5 07			
12-21-64	48' 3/4" Copper tubing				NO CHARGE	
				8-22-60	Labor	1 94
					13' 3/4" Copper tubing	4 77
					1 5/4" CCorp Cock	4 64
					1 3/4" CCurb Cock	6 03
					1 Box & Rod	<u>5 00</u>
						22 38


2238
507
2745

TOWN OF LEXINGTON — BOARD OF PUBLIC WORKS

WATER DIVISION

140

Sketch of Service Here

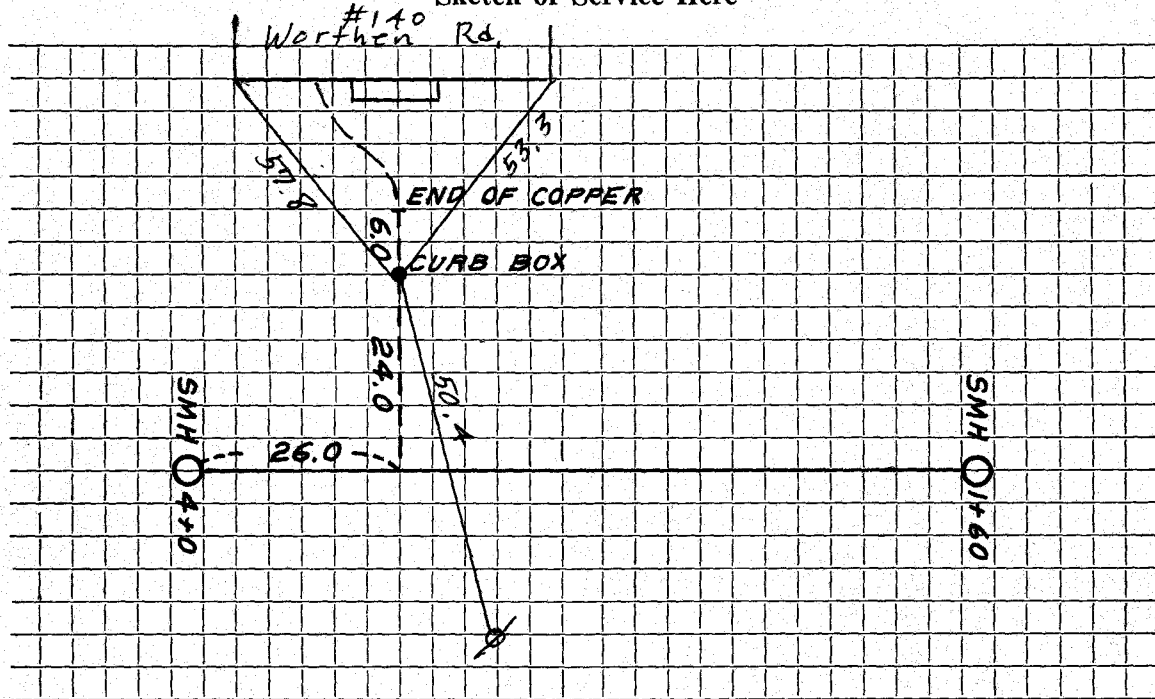

Connection made in Street. Work completed

Remarks:
.....
.....