

WATER SERVICE RECORD

Name Ciampa Bros.

Service No. 129

Address Worthen Road 141

Location Lot 40

~~Request for New Service~~ DeFelice Bros. Permit #A 156


MAR 14 1966

Date	Material	Amount	Total	Date	Amount
8-18-60	Labor	1 94		13-10-65	33 31
	10% O.H.	19	2 13		
	7' 3/4" Copper tubing		2 57		
			4 70		
Nov '65	50' 3/4" Copper tubing				NON CHARGE
				8-18-60	Labor 1 94
					31' 3/4" Copper tubing 11 00
					1 3/4" CCorp Cook 4 64
					1 3/4" CCurb Cook 6 03
					1 Box & Rod 5 00
					28 61
					4 70
					33 31

TOWN OF LEXINGTON — BOARD OF PUBLIC WORKS

WATER DIVISION

Sketch of Service Here

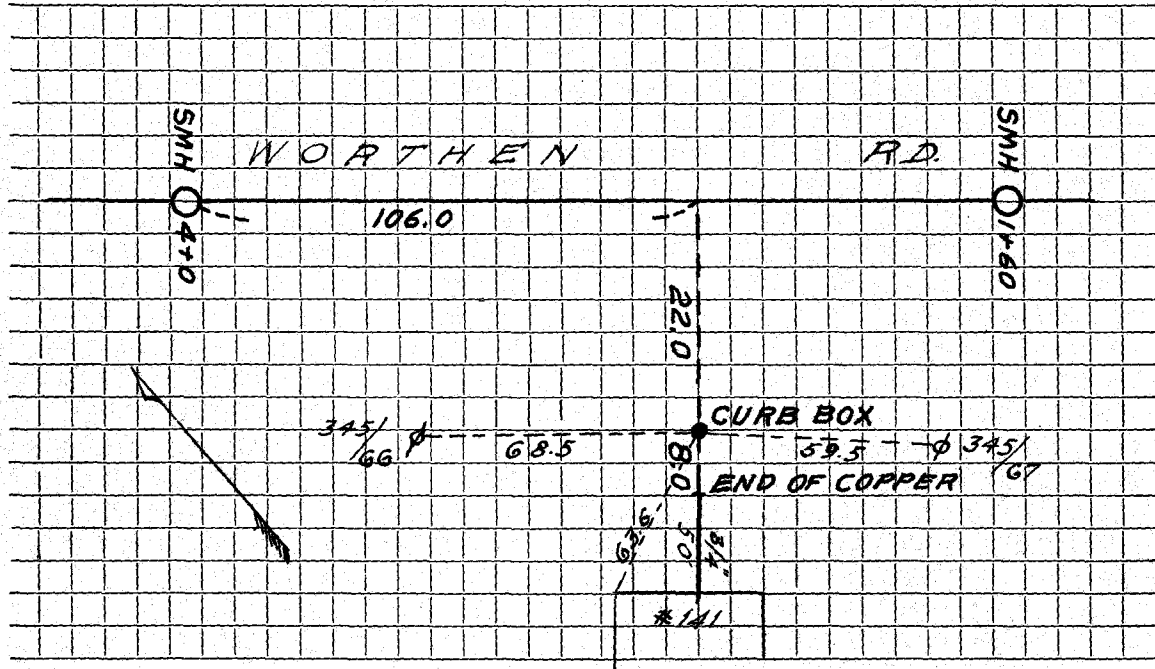

Connection made in Street. Work completed

Remarks:

.....

.....