

WATER SERVICE RECORD

Name

Service No.

Address Worthen Road 144

Location Lot 25


Repair—Renewal—New Service

Date	Material	Amount	Total	Date	Material	Amount
8-18-60	Labor	1 94				
	10% O.H.	<u>19</u>	2 13			
10'	3/4" Copper tubing		<u>3 67</u>			
			5 80			
					NON CHARGE	
				8-18-60	Labor	1 94
					12' 3/4" Copper tubing	4 40
					1 3/4" CCorp Cock	4 64
					1 3/4" CCurb Cock	6 03
					1 Box & Rod	<u>5 00</u>
						22 01

TOWN OF LEXINGTON — BOARD OF PUBLIC WORKS

WATER DIVISION

Sketch of Service Here

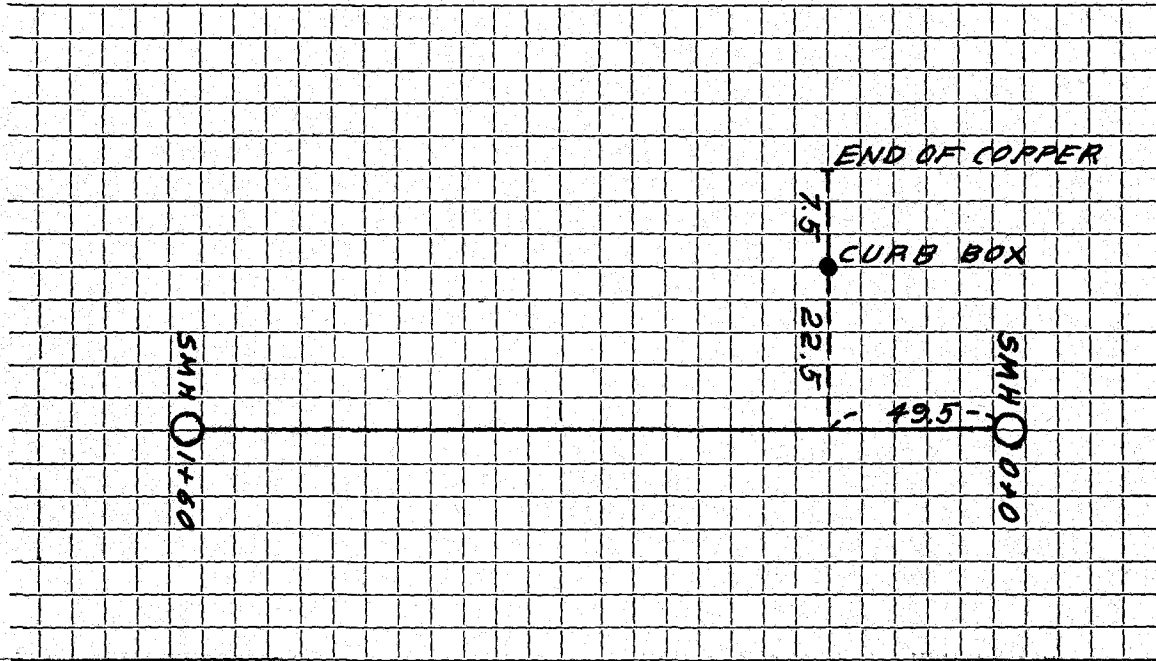

Connection made in Street. Work completed

Remarks:

.....

.....