


DATE _____

TOWN OF LEXINGTON — BOARD OF PUBLIC WORKS

WATER DIVISION

CAPTAIN PARKER ARMS

Sketch of Service Here

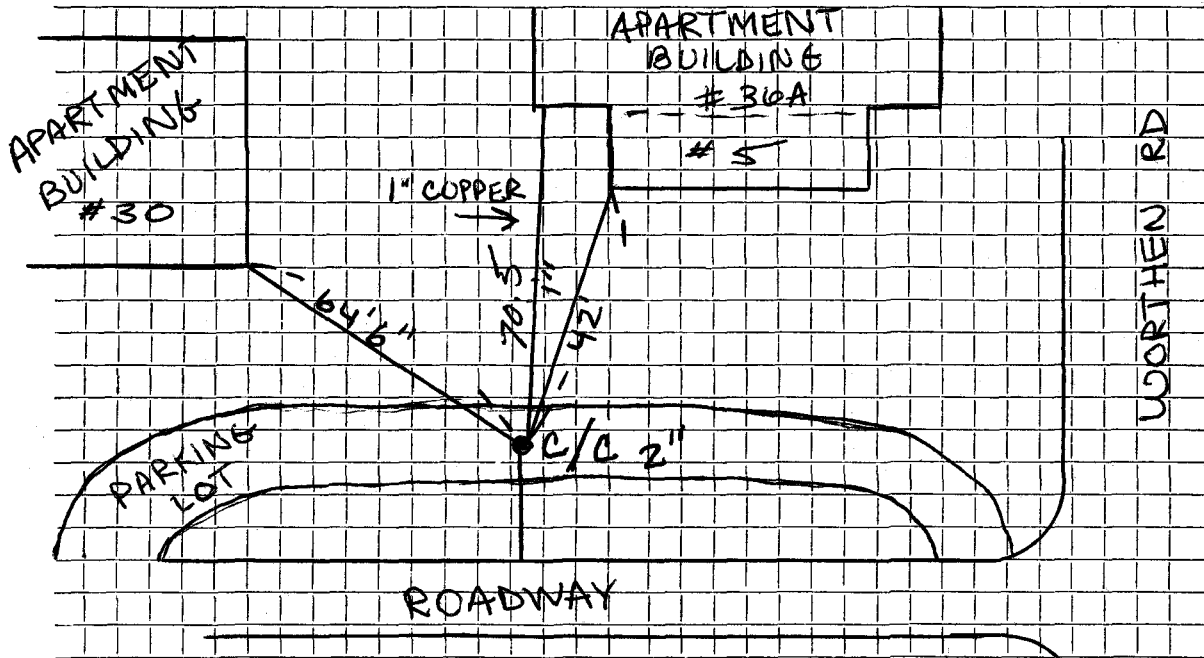

Connection made in Street. Work completed

Remarks: NOTE: NO OUTSIDE TIES