


DATE _____

TOWN OF LEXINGTON — BOARD OF PUBLIC WORKS

WATER DIVISION

Sketch of Service here

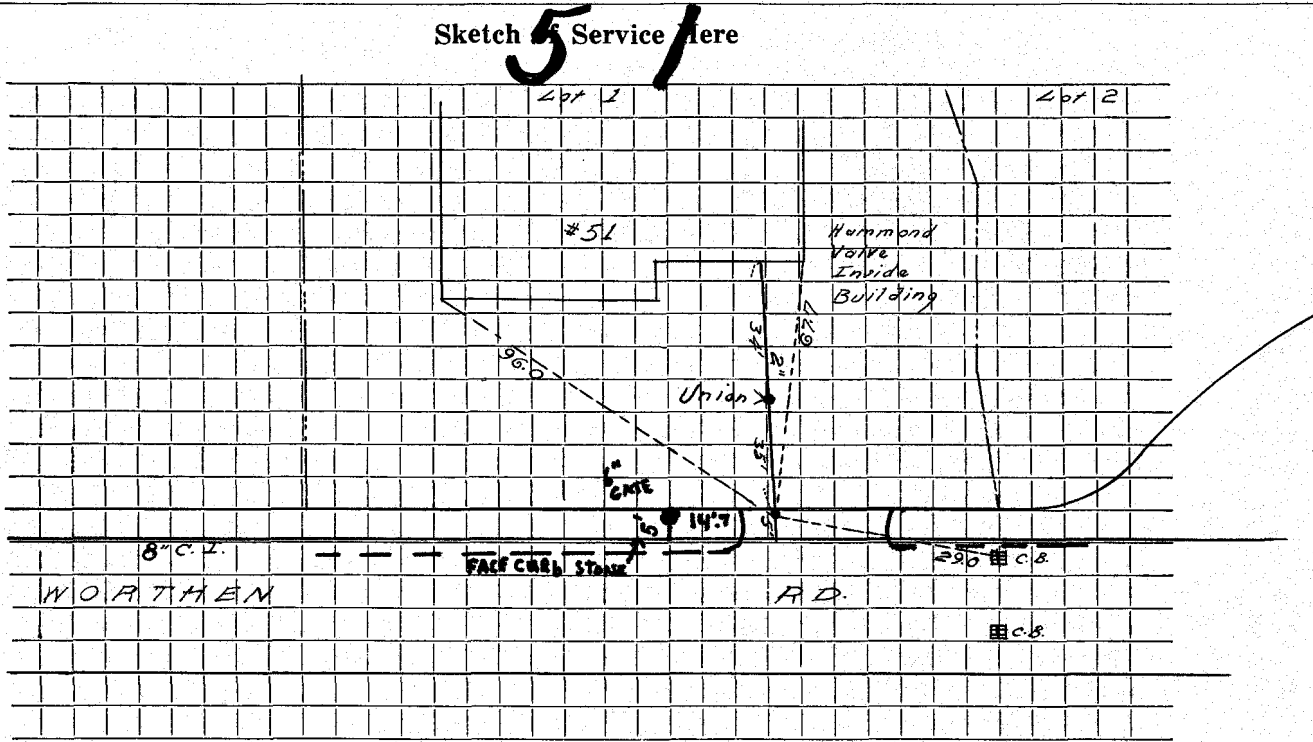

Connection made in Street. Work completed

Remarks: SPRINKLER GATE 5' From Face of Curbstone, 14.7' From Corner of Driveway

.....
.....