


DATE _____

TOWN OF LEXINGTON — BOARD OF PUBLIC WORKS

WATER DIVISION

Sketch of Service Here

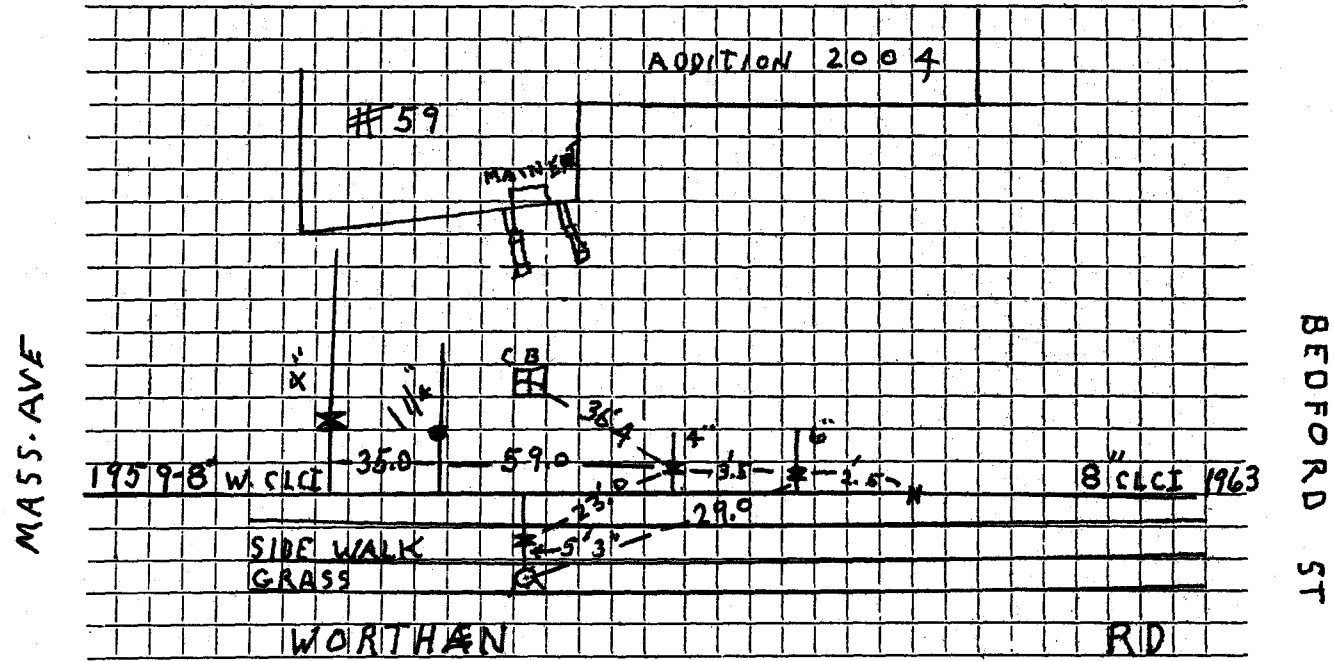

Connection made in WORTHEN RD Street. Work completed July 2004

Remarks: ORIGINAL BUILT 1959

WATER SERVICE RECORD

Name Grace Chapel

Service No.

Address 59 WorThen RD

Location Same

Repair—Renewal—New Service

Date	Material	Amount	Total	Date	Amount
July 2004	4" Duct Iron Pipe				
	8x4 ANCOR. Tee				
	4" 4" D.I.C.L. Pipe				
	4" Gate				
July 2004	6" Duct Iron Pipe				
	8x6 ANCOR. Tee				
	6" Gate				
July 2004	8" MAIN line Gate				
"	1 8" Solid Sleeve				
SPRINKLER	— NOT Used				
6/7/79	8x4 T.S+G.				
	3' 4" Ductile				
	28' 2" Copper				
4/28/59	1 1/4" original service				
	To be Abandon 2004				

DATE _____


TOWN OF LEXINGTON — BOARD OF PUBLIC WORKS

WATER DIVISION

Sketch of Service Here

MASS AVE

BEDFORD ST

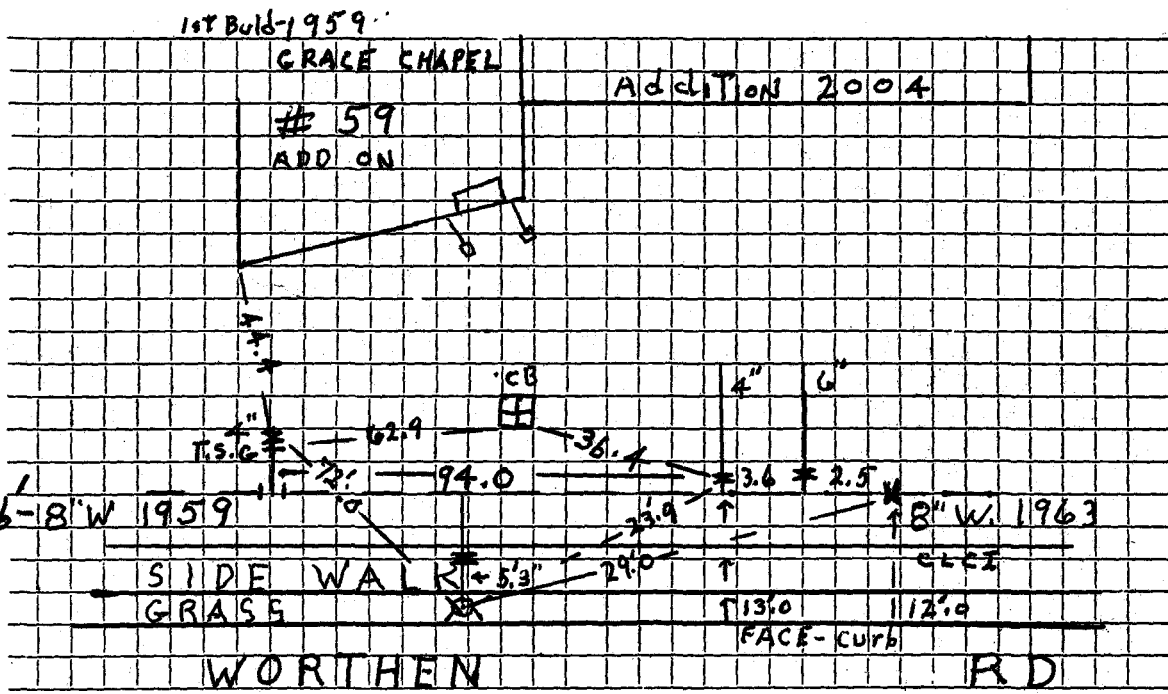

Connection made in Street. Work completed July 2004

Remarks: July 2004. 8"x6" + 8"x4" Tee

Removed 1/2" Copper service INST. IN 1964. INST. 8" MAIN LINE GATE 2004

WATER SERVICE RECORD

Name **Grace Chapel - Leeland Const. Co.**

Service No. 55

Address **59 ~~Worthen Road~~ Worthen Road**

Location

Work **New Service**

Comm **6-1-59**

Date	Material	Amount	Total	Date	Amount
4-28-59	Labor	46.24		4-17-59	Deposit 425.00
	10% O.H.	4.62	50.86	6-1-59	* Refund 135.30
210'	1 1/2" Copper tubing @.8407		176.55		289.70
10'	3/4" Copper tubing @.3666		3.67		NON CHARGE
1	3/4" Cx3/4" I.W.H. Stop & Waste		5.84		Labor 9.99
1	1 1/2" C x 1 1/2" I 2 part union		3.40	3'	2" Cement Lined Pipe @1.09 3.27
1	1 1/4" L.L. Coupling		3.10	1	6" Tap Plug 2.75
1	1" C x 1" Iron 2 part union		1.97	1	2" x 1 1/4" Reduce Coupling 3.35
1	3/4" C 3 part union		2.27	1	1 1/4" Curb Cock 15.91
3	1 1/2" 3 part unions @5.18		15.54	1	Box & Rod 5.00
2	hrs. Town Shovel @6.50		13.00		40.27
2	hrs. Trucking @.75		1.50		
1	hr. Rodgers Trailer @3.00		3.00		
1	hr. Trucking @3.00		3.00		
2	hrs. Allis Chalmer @3.00		6.00		
2004	To be Abandon + Disconnected		289.70		


* Apply to WHOT# 1 and

DATE _____

TOWN OF LEXINGTON — BOARD OF PUBLIC WORKS

WATER DIVISION

Sketch of Service Here

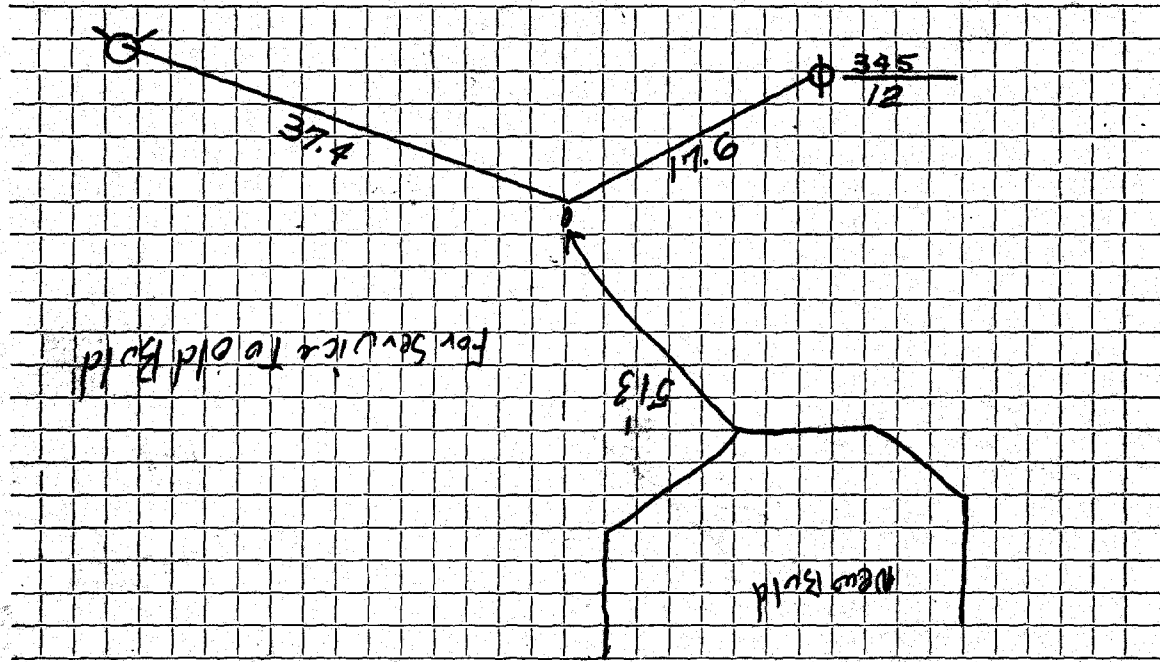

Connection made in Street. Work completed

Remarks: 2004 To be Abandoned.