

WATER SERVICE RECORD

Name Stop & Shop (Flatelli Corp.-Braintree)

Service No. 72

Address Worthen Road

Location

Repair—Renewal—New Service

MAY 2 1966


Date	Material	Amount	Total	Date	Amount
8-2-65	Labor	100.23		7-23-65	1000 00
8-3-65	"	97.61			852 12
8-4-65	"	101.35			1850 12
8-5-65	"	37.30	336.29		
	10% O.H.	33.63	369.92		
	8 x 8 tap sleeve & gate		210.57		
64'	8" Cast iron pipe @2.79		178.56		
12'	6" cast iron pipe @2.17		26.04		
	8 x 6 Tee		5.25		
1	5" Hydrant		184.59		
	18" Extension		49.44		
	50 x 3 Patch		50.00		
1	6" Gate		72.09		
1	Gate Box		15.95		
8	ton stone @1.10		8.80		
6	hrs. town truck @3.00		18.00		
12	hrs. Tractor @6.50		78.00		
			1,267.21		
	2nd Canal		582 91		1850 12

DATE _____

TOWN OF LEXINGTON — BOARD OF PUBLIC WORKS

WATER DIVISION

Sketch of Service Here

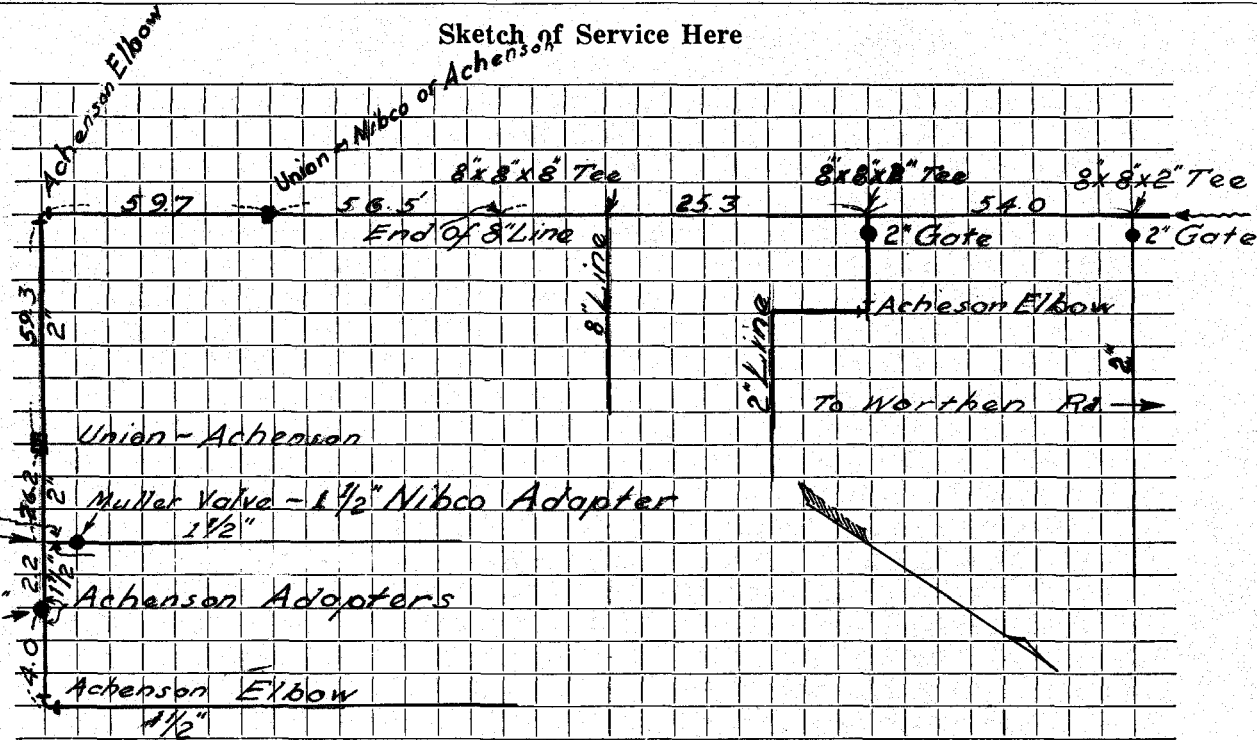

For Continuation See Other Card

Connection made in Street. Work completed

Remarks:
.....
.....