

WATER SERVICE RECORD

Name Reginald Wood

Service No. 207

Address 4 Wright Street

2506

Location


~~XXXXXXXXXXXX~~ New Service

Comm 11-30-59

Date	Material	Amount	Total	Date	Material	Amount
9-16-59	Labor	26.22		9-4-59	Deposit	100.00
	10% O.H.	2.62	28.84	11-30-59	Returned	24.15
60'	3/4" Copper tubing@ .41		24.60			7.382
1	3/4" C x 1/2 I.W.H. Stop&Waste		5.88			
2	Hrs. Town shovel@ 6.50		13.00		NON CHARGE	
2	Hrs. Trucking@ .75		1.50		Labor	6.18
			73.82			
				15'	3/4" Copper tubing@ .41	6.15
				1	3/4" C Copp Cock	4.67
				1	3/4" C Curb Cock	5.98
				1	Box & Rod	5.00
				1	1/2 Straight tailpiece	.50
				1	1/2 Offset tailpiece	.50
				1	Hr. Town shovel@ 6.50	6.50
				1	Hr. Trucking@ .75	.75
						36.23

TOWN OF LEXINGTON — BOARD OF PUBLIC WORKS
WATER DIVISION

Sketch of Service Here

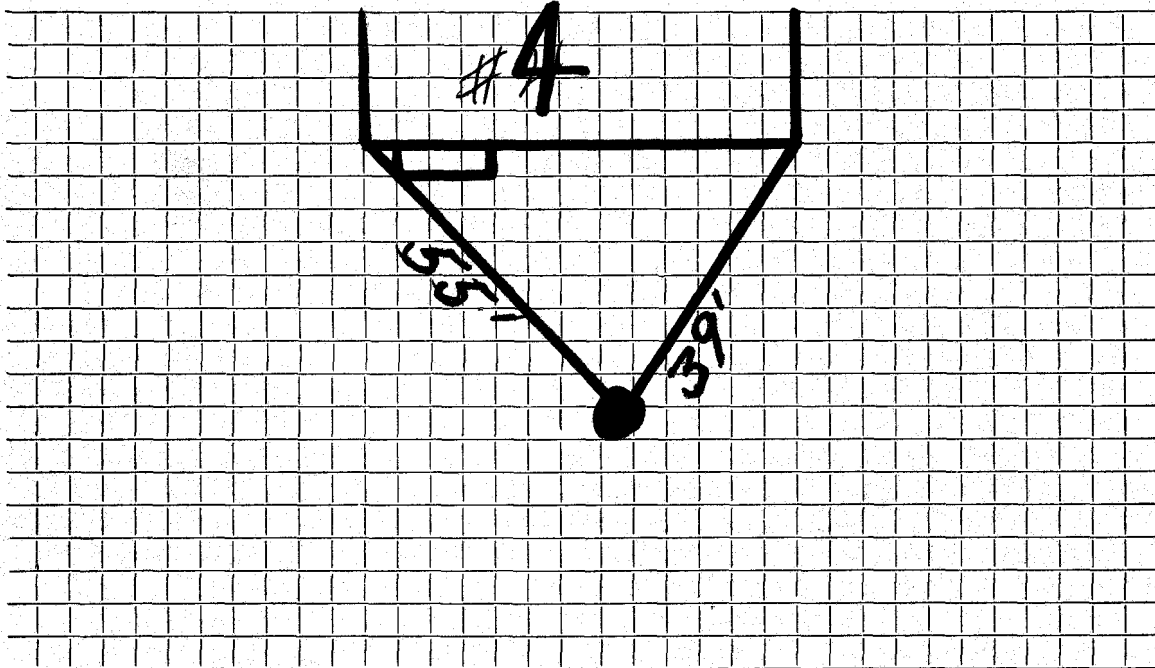

Connection made in Street. Work completed

Remarks:
.....
.....