

Name Dominic Iovino

Service No.

265

Address Wright Street (Hen House)

Location 8 Wright Street

Kind of Pipe

Size

Size of Main

~~XXXXXX~~ ~~XXXXXX~~ New Service

Com. 12-31-49

Location

Date	Material	Amount	Total	Date	Amount
Dec. 27, '49	Labor	1 35	1 35	Dec. 27, '49	40 00
	10% Overhead		14	Dec. 31, '49	3 23
	95' - 1" Copper Tubing @.28	26 60			36 27
	1 - 1"C x 1"I.W.H. S&W	5 60		Dec. 27, '49	5 00
	1 - 1"C x 1"C Union (3pts)	1 83		25' - 1" Copper tubing @.28	7 00
	Trucking 1 hr. @.75		75	1 - 1"C Corp-cock	4 62
			36 27	1 - 1"C x 1"C Curb-cock	5 60
				1 - Box & Rod	3 75
				1 - 3/4" Straight Tail Piece	37
				1 - 3/4" Offset Tail Piece	37
				Littlefield Shovel 2 hrs. @ 7.00	14 00
				Trucking 1 hr. @.75	75
	Labor				41 46

DATE \_\_\_\_\_

# TOWN OF LEXINGTON – BOARD OF PUBLIC WORKS

## WATER DIVISION

The undersigned applies for a supply of water at No..... St. and hereby agrees to comply with the rules and regulations as now, or at any future time, established by the Board of Selectmen.

Am't of Estimate \$.....

Owner .....

Am't Paid \$.....


Address .....

Builder .....

.....

Sketch of Service Here

8

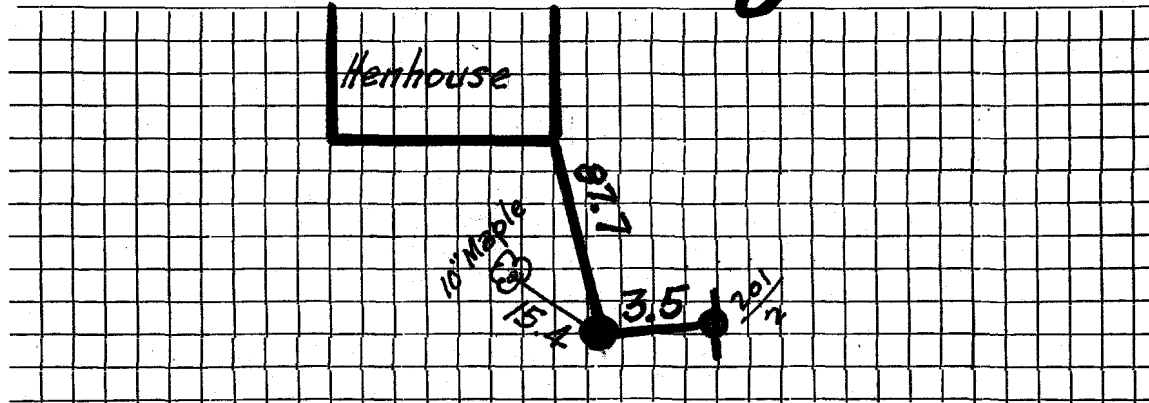

Connection made in ..... Street.

Work completed .....19

Remarks: