

WATER SERVICE RECORD

4888

Name Reginald Wood

Service No. 239

Address 3 Wright Street

Location

~~Repair~~ ~~Renewal~~ - New Service


Comm 11-30-59

Date	Material	Amount	Total	Date		Amount
9-28-59	Labor	28.12		9-25-59	Deposit	100.00
	10% O.H.	2.81	30.93	10-30-59	Returned	36.27
40'	3/4" Copper tubing@ .41		16.40			63.71
1	3/4" C x 1/2 I.W.H. Stop&Waste		5.88			
1	Hr. Trucking@ .75		.75		NON CHARGE	
1 1/2	Hr. Town shovel@ 6.50		9.75		Labor	7.03
			63.71			
				10'	3/4" Copper tubing@ .41	4.10
				1	3/4" C Corp Cock	4.67
				1	3/4" C Curb Cock	5.98
				1	Box & Rod	5.00
				1	1/2 Straight tailpiece	.50
				1	1/2 Offset tailpiece	.50
				1/2	Hr. Town shovel@ 6.50	3.25
						31.03

TOWN OF LEXINGTON — BOARD OF PUBLIC WORKS

WATER DIVISION

Sketch of Service Here

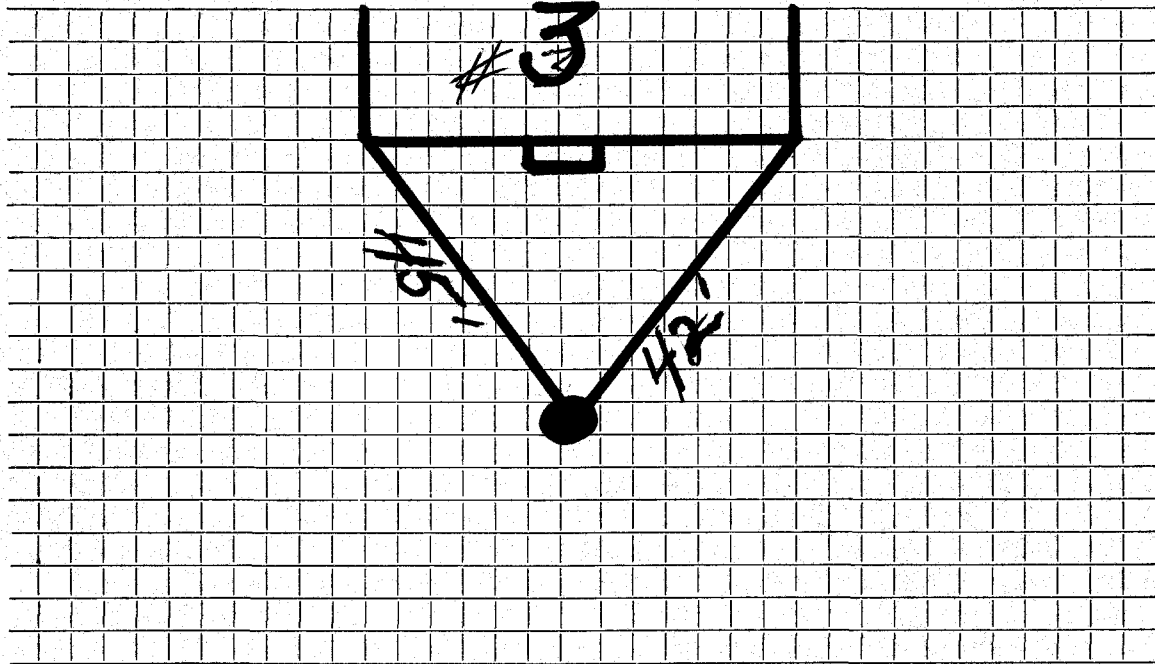

Connection made in Street. Work completed

Remarks:
.....
.....